IREDELL COUNTY HEALTH DEPARTMENT

STATESVILLE 704-878-5305 MOORESVILLE 704-664-5281

10/31/97 1-2

IMPROVEMENT PERMIT / CERTIFICATE OF COMPLETION / OPERATION PERMIT / EXISTING SYSTEM INSPECTION

PROPERTY DESCRIPTION NO. 21354 DATE 7/7/95 TAX MAP NO. 3F-6-A-12

OWNER OR CONTRACTOR Fred Wall Watershed: ☐ Yes ☒ No

ADDRESS 12 Bell St. Mooresville, NC. 28115 PHONE: Business 4649-28-0147 Home 664-2978

LOCATION Jessmine Cir

SUBDIVISION King Acres BLOCK / SECTION LOT 12 LOT AREA 100 x 200 SITE CLASS. PS DESIGN FLOW 360 L.T.A.R. .4

Septic Tank: 1000 Gallons; STB 1012 Date 5/15/97

Pump Tank: Gallons; PT Date

Pump Make: Model Serial No.

Nitrification Field: No. Fields 1 Square Feet 1200 Linear Feet *300

No Lines 3 (9) Trench Width 36" Max Trench Bottom Depth 36" Gravel Depth N/A

☒ New System ☐ Repair System Type: I, II, (III), IV, V, VI

System Description: Infiltrator CONVENTIONAL

Repair System Description:

Maintenance Agreement Required: ☐ Yes ☒ No

☒ House/Mod. Home No. Bedrooms 3

☐ Mobile Home No. Bathrooms 2

☐ Business No. Employees

☐ Other


☐ Slab ☒ Crawl Space ☐ Basement w/plumbing ☐ Basement wo/plumbing

Water Supply: ☐ Individual ☒ Community ☐ Public

Comments: * 25% reduction for Infiltrator use

Comments:

INITIAL SITE SKETCH

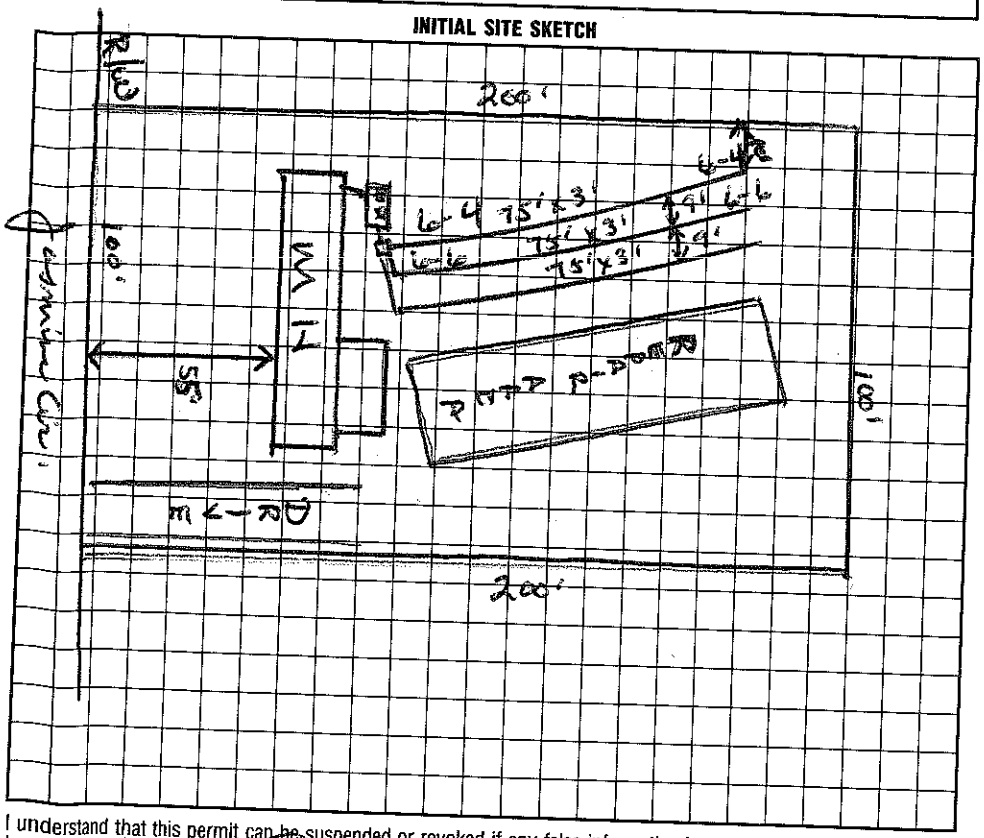

AS BUILT SKETCH

I understand that this permit can be suspended or revoked if any false information is supplied toward securing the permit/any unauthorized changes are made to the site/any unauthorized changes are made in the installation of the system. Improvement Permit is valid for 60 months from date of issuance.

Signed: x Fred Maxwell

Improvement Permit by: Wesley Sparks R.S. date 7/7/95

Existing System Inspection by: date

Installed by: Ace Contractors

Certificate of Completion by: date

Operation Permit by: C. Ray Tew date 11/3/97

HEALTH DEPT. COPY: WHITE INSPECTION COPY (FINAL): GREEN OWNER COPY (FINAL): YELLOW INSPECTION COPY (INITIAL): PINK OWNER COPY (INITIAL): GOLD