2:00-3:00 lines

IREDELL COUNTY HEALTH DEPARTMENT

STATESVILLE 704-878-5305 MOORESVILLE 704-664-5281

IMPROVEMENT PERMIT / CERTIFICATE OF COMPLETION / OPERATION PERMIT / EXISTING SYSTEM INSPECTION

PROPERTY DESCRIPTION NO. 067953 DATE 8/6/97 TAX MAP NO. 4649283856 Watershed: ☒ Yes ☐ No

OWNER OR CONTRACTOR Paula Cowan PHONE: Business _____ Home 663-3338/528-6286

ADDRESS P.O. Box 5416 Statesville, NC 28687

LOCATION 21N to Hower House Loop to Carlyle TR. Jasmine Circle

SUBDIVISION King Acres BLOCK / SECTION 2 LOT 37 LOT AREA _____ SITE CLASS. PS DESIGN FLOW 240gpd L.T.A.R. .3

Septic Tank: 1000 Gallons; STB _____ Date _____

Pump Tank: _____ Gallons; PT 47 Date 3/17/98

Pump Make: HYDROMATIC Model _____ Serial No. _____

Nitrification Field: No Fields 1 Square Feet _____ Linear Feet 268'

No Lines 4 at 67' Trench Width 36" Max Trench Bottom Depth 24" Gravel Depth 12"

☒ New System ☐ Repair System Type: I, II, (III), IV, V, VI

System Description: Pump to Conventional

Repair System Description: Pump to Panel Blk

Maintenance Agreement Required: ☐ Yes ☒ No

☐ House/Mod. Home ☒ Mobile Home ☐ Business ☐ Other

No. Bedrooms 2 No. Bathrooms 2 No. Employees _____


☐ Slab ☒ Crawl Space ☐ Basement w/plumbing ☐ Basement wo/plumbing

Water Supply: ☐ Individual ☒ Community ☐ Public

Comments: Keep Septic System at least 10' from property lines

Comments: 2 BRs

INITIAL SITE SKETCH Scale 1:100

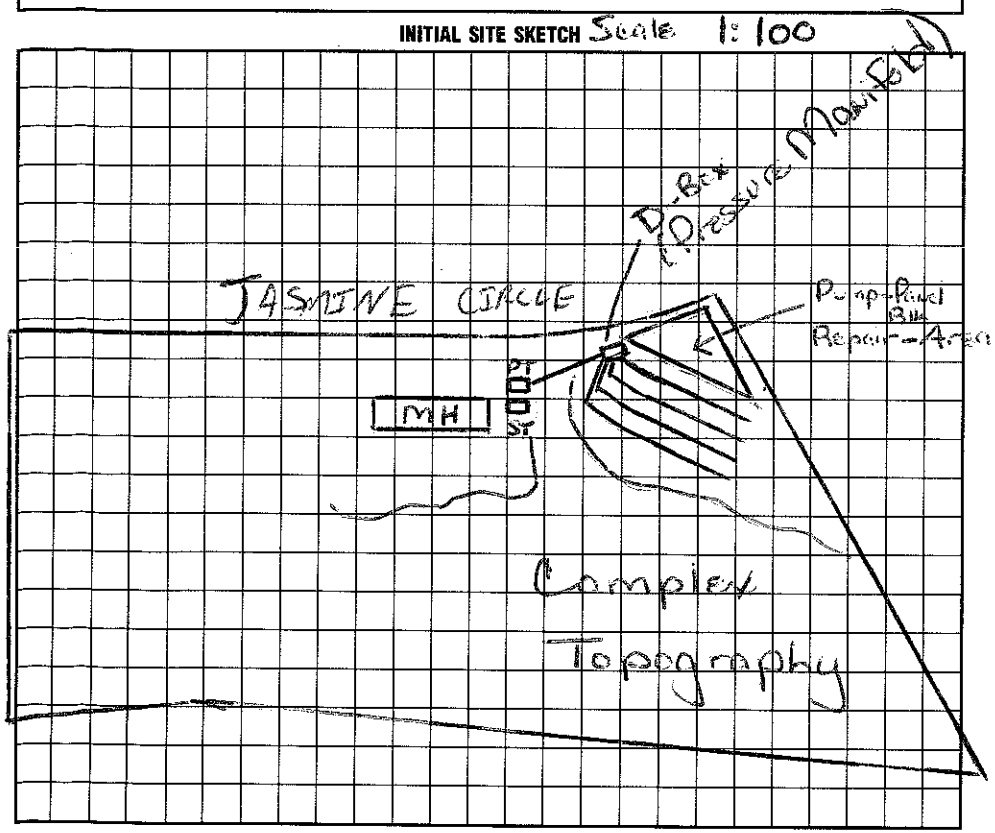

AS BUILT SKETCH

I understand that this permit can be suspended or revoked if any false information is supplied toward securing the permit/any unauthorized changes are made to the site/any unauthorized changes are made in the installation of the system. Improvement Permit is valid for 60 months from date of issuance.

Signed: Paula K. Cowan

Improvement Permit by: Maria Dotson date 8/8/97

Existing System Inspection by: Maria Dotson date 8/8/97

Installed by: Lejeune Environmental

Certificate of Completion by: Wesley Sparks RS. date 7/16/98

Operation Permit by: Wesley Sparks RS date 7/16/98

HEALTH DEPT COPY: WHITE INSPECTION COPY (FINAL): GREEN OWNER COPY (FINAL): YELLOW INSPECTION COPY (INITIAL): PINK OWNER COPY (INITIAL): GOLD