# IREDELL COUNTY HEALTH DEPARTMENT

STATESVILLE 704-878-5305 / 125.00 Paid MOORESVILLE 704-664-5281

## IMPROVEMENT PERMIT / AUTHORIZATION TO CONSTRUCT / OPERATION PERMIT / EXISTING SYSTEM INSPECTION

PERMIT# 91363 PIN# ~~4740 20 3493 NF~~ 4649292937 DATE 5/17/01

OWNER OR CONTRACTOR A H Inc PHONE: Business 636-7765 Home

ADDRESS 2310 S Main ST Salisbury NC 28147

LOCATION Perth R Cloatz Hill, R Ridge, CK R Wiltshire, R Panther Crk on LT.

SUBDIVISION Wiltshire Crt BLOCK / SECTION LOT 55 LOT AREA 0.52 ac. SITE CLASS. PS DESIGN FLOW 360 L.T.A.R. 0.3

Septic Tank: 1000 Gallons; STB 325 Date 6/7/01
Pump Tank: Gallons; PT Date
Pump Make: Model Serial No.
Nitrification Field: No Fields 1 Square Feet 900 Linear Feet 300
No Lines 5 Trench Width 36" Max Trench Bottom Depth 36" Gravel Depth —

☒ New System ☐ Repair System Type: I, II, III, IV, V, VI
System Description: Gravity 25% Red
Repair System Description: LP pump
Maintenance Agreement Required: ☐ Yes ☐ No

☒ House/Mod. Home No. Bedrooms 3
☐ Mobile Home No. Bathrooms 2
☐ Business No. Employees
☐ Other


☐ Slab ☐ Crawl Space ☐ Basement w/plumbing ☐ Basement wo/plumbing

Water Supply: ☒ Individual ☐ Public ☐ Community

Comments:/Conditions:

Comments:/Conditions:
Installed as drawn

INITIAL SITE SKETCH

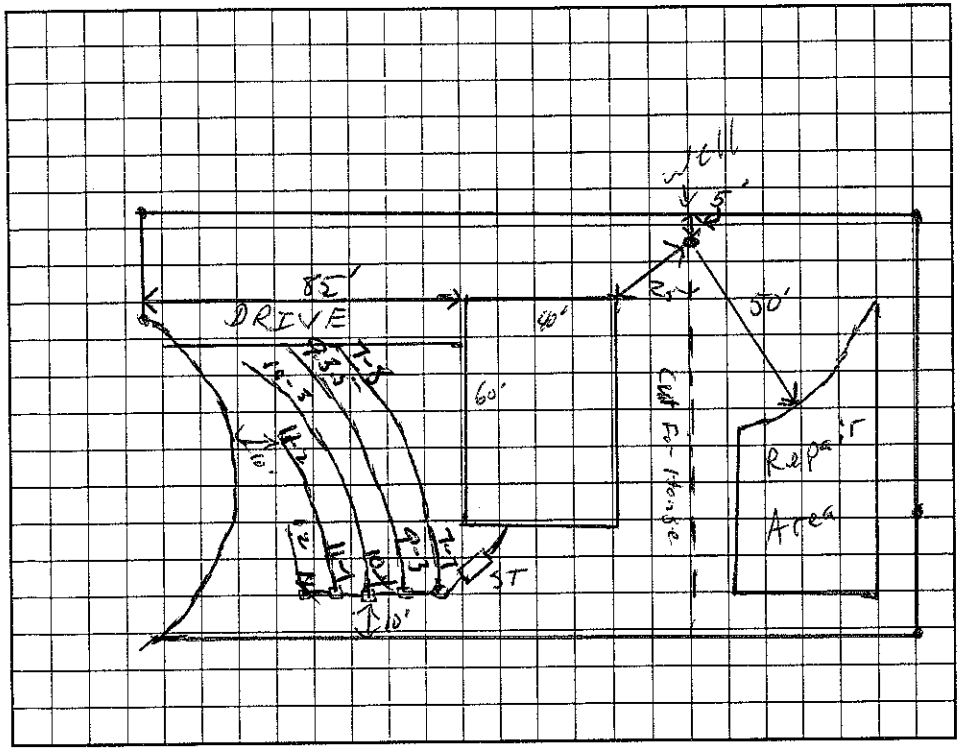


AS BUILT SKETCH

Permit can be suspended or revoked if any false information is supplied toward securing the permit/any unauthorized changes are made to the site/any unauthorized changes are made in the installation of the system. Improvement Permit with plat valid without expiration. Improvement Permit with site plan valid for sixty months. Authorization to Construct is valid for a period equal to that of Improvement Permit – not to exceed sixty months.

Signed: date 5/24/01 Installed by: Rowan Septic Tank

Improvement Permit by: RSI date 5/17/01 Operation Permit by: Wesley Sparks RS. date 8/17/01

Authorization to Construct by: RSI date 5/17/01 Existing System Inspection by: date

HEALTH DEPT. COPY: WHITE OWNER COPY (FINAL): YELLOW OWNER COPY (INITIAL): PINK