IREDELL COUNTY HEALTH DEPARTMENT

STATESVILLE 704-878-5305 MOORESVILLE 704-664-5281

IMPROVEMENT PERMIT / AUTHORIZATION TO CONSTRUCT / OPERATION PERMIT / EXISTING SYSTEM INSPECTION

PERMIT# 116010 PIN# ~~4649 301233.6~~ 4649-30-1272 DATE 10/15/03

OWNER OR CONTRACTOR CORINTHIAN DEVELOPERS PHONE: Business 827-9697 Home

ADDRESS PO BOX 990 - DENVER NC 28037

LOCATION CORNELIUS RD - TR JUDAS - ON LT

SUBDIVISION TANGLEWOOD BLOCK / SECTION LOT 6 LOT AREA 25492 SITE CLASS. PS DESIGN FLOW 360GPD L.T.A.R. .3GPD/FT2

Septic Tank: 1000 Gallons; STB 785 Date 6/29/04
Pump Tank: 1000 Gallons; PT 40 Date 6/30/04
Pump Make: Model Serial No.
Nitrification Field: No Fields 1 Square Feet 420 Linear Feet 210
No Lines 4 Trench Width 24" Max Trench Bottom Depth 36" Gravel Depth N/A

☑ New System ☐ Repair System Type: I, II, III, (IV), V, VI
System Description: LP PANEL
Repair System Description: SAME
Maintenance Agreement Required: ☑ Yes ☐ No
☐ Slab ☑ Crawl Space ☐ Basement w/plumbing ☐ Basement wo/plumbing


☑ House/Mod. Home No. Bedrooms 3
☐ Mobile Home No. Bathrooms 3
☐ Business No. Employees
☐ Other

Water Supply:
☑ Individual
☐ Public
☐ Community


Comments:/Conditions:

Comments:/Conditions:

INITIAL SITE SKETCH 1" = 60'

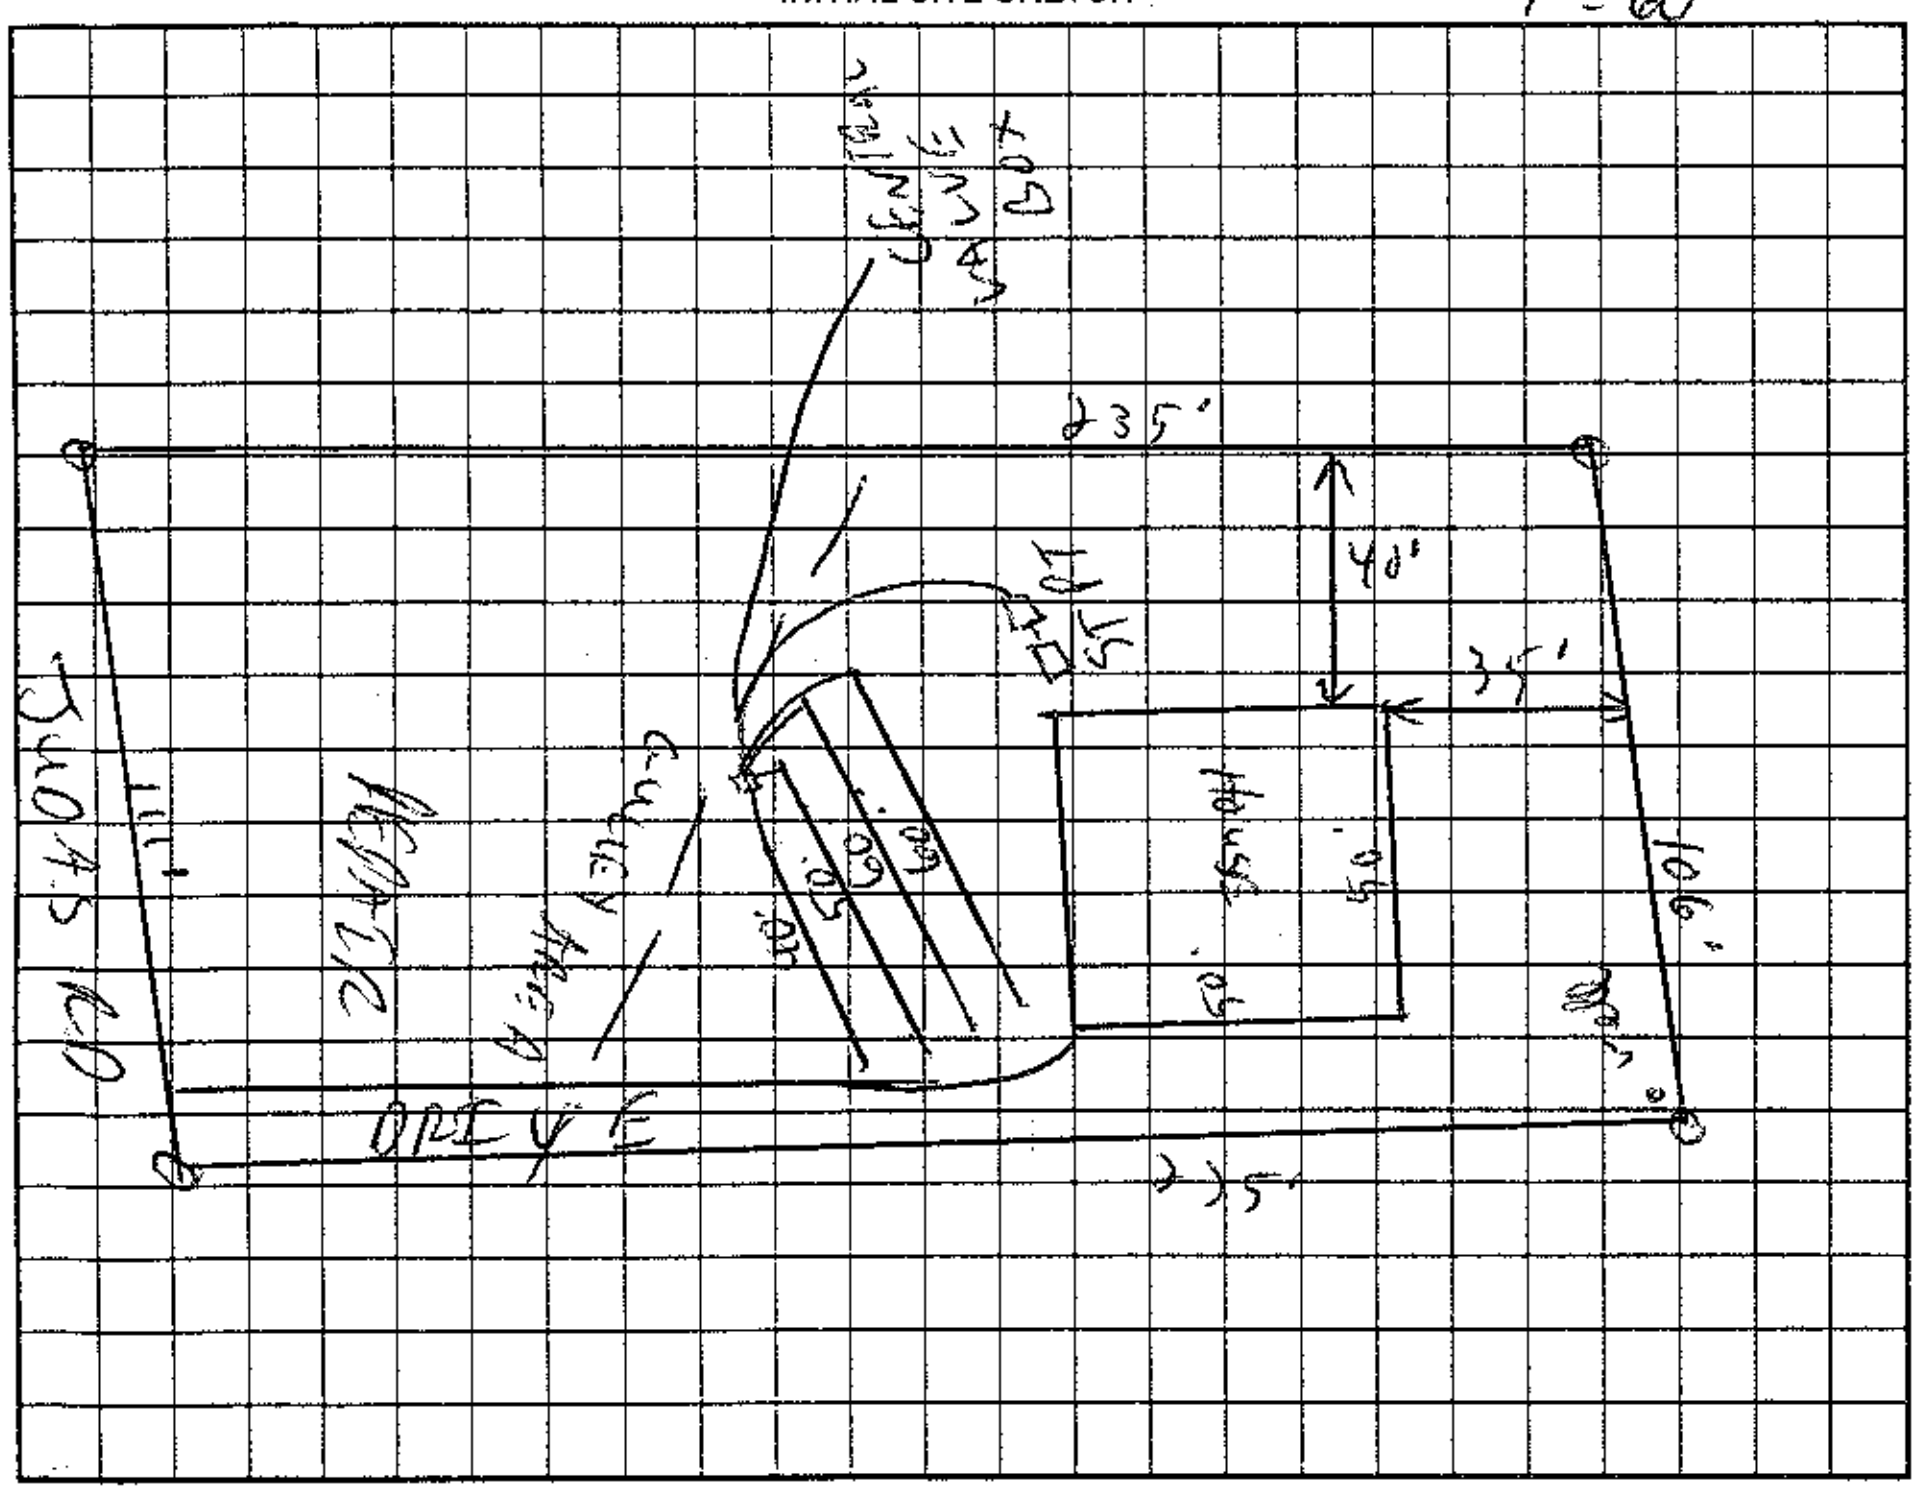

AS BUILT SKETCH

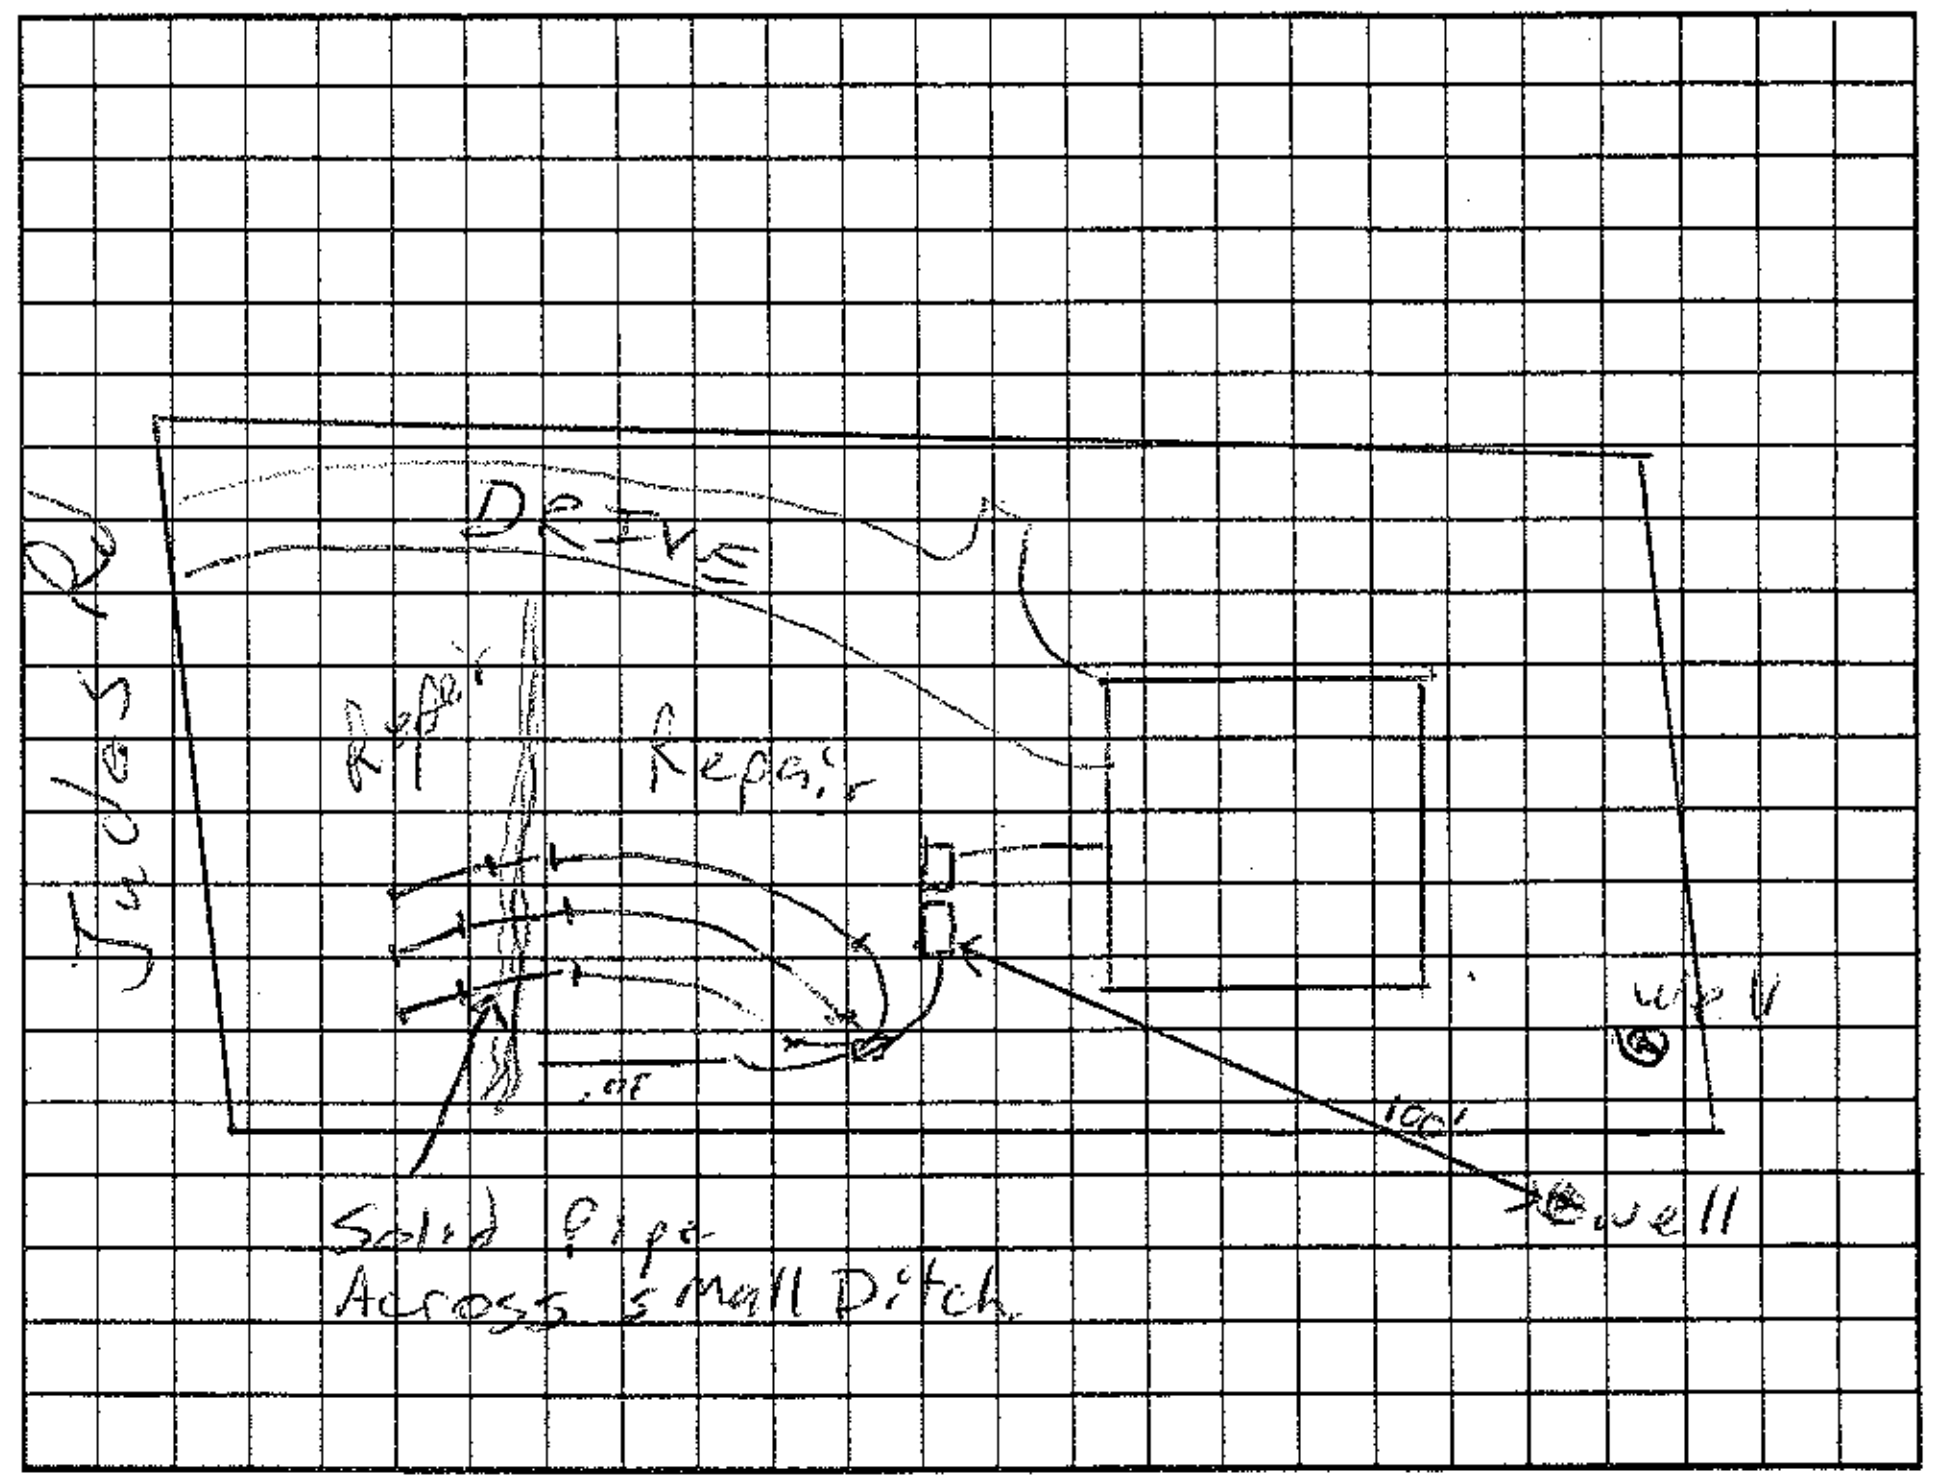

Permit can be suspended or revoked if any false information is supplied toward securing the permit/any unauthorized changes are made to the site/any unauthorized changes are made in the installation of the system. Improvement Permit with plat valid without expiration. Improvement Permit with site plan valid for sixty months. Authorization to Construct is valid for a period equal to that of Improvement Permit – not to exceed sixty months.

Signed: [signature] date 10-15-03 Installed by: Corinthian Development

Improvement Permit by: [signature] RS date 10/15/03 Operation Permit by: [signature] RS date 3/11/04

Authorization to Construct by: [signature] RS date 10/15/03 Existing System Inspection by: date

HEALTH DEPT. COPY: WHITE OWNER COPY (FINAL): YELLOW OWNER COPY (INITIAL): PINK