IREDELL COUNTY HEALTH DEPARTMENT

STATESVILLE 704-878-5305 375.00 Paid MOORESVILLE 704-664-5281

IMPROVEMENT PERMIT / AUTHORIZATION TO CONSTRUCT / OPERATION PERMIT / EXISTING SYSTEM INSPECTION

PERMIT# 116078 PIN# 4649-30-1233.000 4649-30-2083 DATE Feb 17, 04

OWNER OR CONTRACTOR Corinthian Developers Ltd. PHONE: Business _____ Home _____

ADDRESS P.O. Box 990, Denver, N.C. 28037

LOCATION From Mooresville, US 21N, TR Cornelius Rd. TR Judas Rd. ~ 1/4 mile on left

SUBDIVISION Tanglewood BLOCK / SECTION _____ LOT 8 LOT AREA 25,000 ft² SITE CLASS. PS DESIGN FLOW 360 gpd L.T.A.R. .25

Septic Tank: 1000 Gallons; STB 786 Date 1/4/04

Pump Tank: 1000 Gallons; PT 32 Date 1/4/04

Pump Make: Myers Model ME50 SA11 Serial No. _____

Nitrification Field: No Fields 1 Square Feet 460 Linear Feet 240

No Lines 5 Trench Width 24" 8'oc Max Trench Bottom Depth 36" Gravel Depth NA

☑ New System ☐ Repair System Type: I, II, III, IV, V, VI

System Description: LPPPBPS

Repair System Description: LPPPBPS

Maintenance Agreement Required: ☑ Yes ☐ No

☑ House/Mod. Home No. Bedrooms 3

☐ Mobile Home No. Bathrooms 2

☐ Business No. Employees _____

☐ Other _____


☑ Slab ☐ Crawl Space ☐ Basement w/plumbing ☐ Basement wo/plumbing

Water Supply: ☑ Individual ☐ Public ☐ Community

Comments:/Conditions:

Comments:/Conditions:

1"=60' INITIAL SITE SKETCH

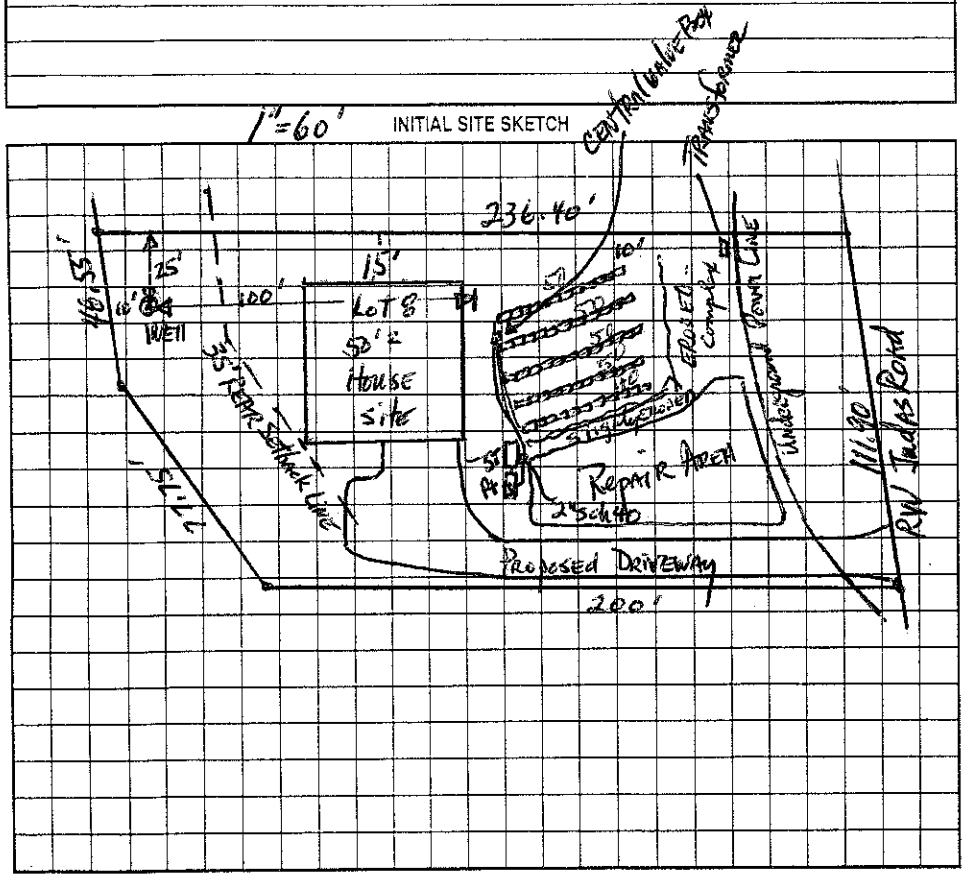

AS BUILT SKETCH

Permit can be suspended or revoked if any false information is supplied toward securing the permit/any unauthorized changes are made to the site/any unauthorized changes are made in the installation of the system. Improvement Permit with plat valid without expiration. Improvement Permit with site plan valid for sixty months. Authorization to Construct is valid for a period equal to that of Improvement Permit – not to exceed sixty months.

Signed: _____ date 3-2-04 Installed by: Corinthian Bldrs

Improvement Permit by: _____, RS date 2-17-04 Operation Permit by: _____, RS date 6/14/04

Authorization to Construct by: _____, RS date 3/3/04 Existing System Inspection by: _____ date _____

HEALTH DEPT. COPY: WHITE OWNER COPY (FINAL): YELLOW OWNER COPY (INITIAL): PINK