IREDELL COUNTY HEALTH DEPARTMENT

4649340633

STATESVILLE 704-878-5305 MOORESVILLE 704-664-5281

IMPROVEMENT PERMIT / CERTIFICATE OF COMPLETION / OPERATION PERMIT / EXISTING SYSTEM INSPECTION

PROPERTY DESCRIPTION NO. 7225 DATE Nov. 17, 195 TAX MAP NO. 25A56

OWNER OR CONTRACTOR Debbie McCombs PHONE: Business _____ Home _____ Watershed: ☑ Yes ☐ No

ADDRESS PO Box 1214 Troutman W54CA

LOCATION South RD N. TR Fero Hill Rd. past jct w/ Carlyle Rd ~ ¼ mile TR just past church Old under const

SUBDIVISION _____ BLOCK / SECTION _____ LOT _____ LOT AREA 1 AC SITE CLASS. B DESIGN FLOW 360gpd L.T.A.R. .3

Septic Tank: 1000 Gallons; STB 1012 Date 11/11/95

Pump Tank: _____ Gallons; PT _____ Date _____

Pump Make: _____ Model _____ Serial No. _____

Nitrification Field: No. Fields 1 Square Feet 1200 Linear Feet 400

No Lines 4@100' Trench Width 36" Max Trench Bottom Depth 36" Gravel Depth 12"

☑ New System ☐ Repair System Type: I, II, III, IV, V, VI

System Description: gravity conventional

Repair System Description: same

Maintenance Agreement Required: ☐ Yes ☑ No

☑ House/Mod. Home No. Bedrooms 3

☑ Mobile Home No. Bathrooms 2

☐ Business No. Employees _____

☐ Other _____

☐ Slab ☑ Crawl Space ☐ Basement w/plumbing ☐ Basement wo/plumbing

Water Supply:
☑ Individual OW
☐ Community
☐ Public


Comments:

PL 2091

Comments:

classified as shown on Imp. Permit.

INITIAL SITE SKETCH

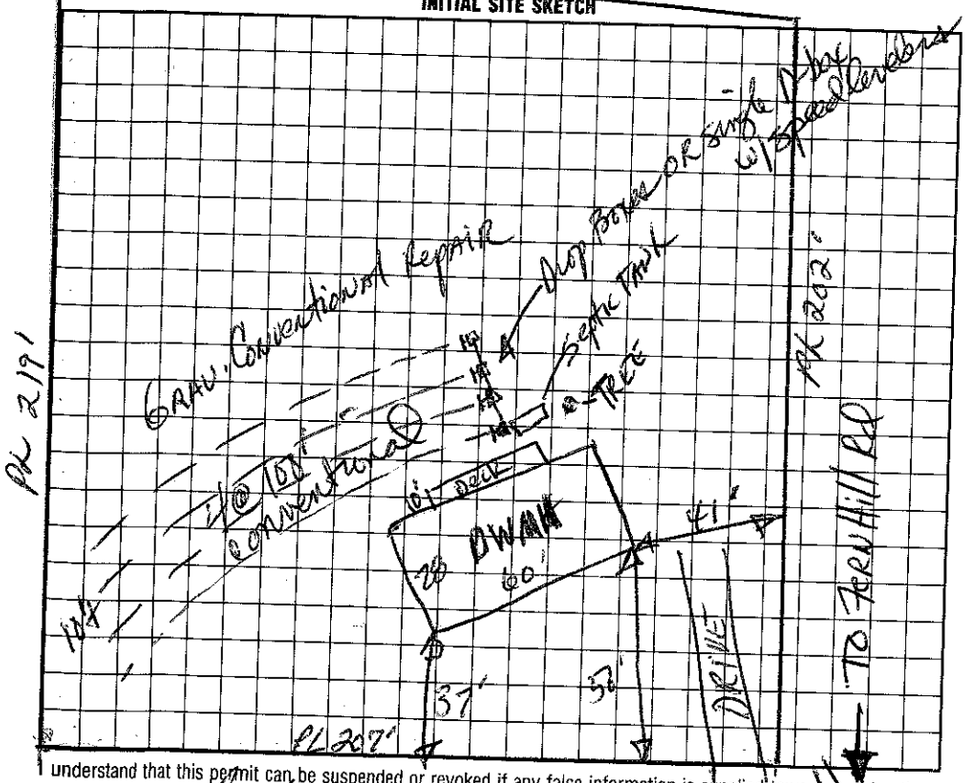

AS BUILT SKETCH

I understand that this permit can be suspended or revoked if any false information is supplied toward securing the permit/any unauthorized changes are made to the site/any unauthorized changes are made in the installation of the system.

Signed: Debbie McCombs

Improvement Permit by: _____ date 11-17-95

Existing System Inspection by: _____ date 11-17-95

Installed by: Dale Fox

Certificate of Completion by: Wesley Sparks R.S. date 2/14/96

Operation Permit by: Wesley Sparks R.S. date 2/14/96

HEALTH DEPT. COPY: WHITE INSPECTION COPY (FINAL): GREEN OWNER COPY (FINAL): YELLOW INSPECTION COPY (INITIAL): PINK OWNER COPY (INITIAL): GOLD