IREDELL COUNTY HEALTH DEPARTMENT

AUTHORIZATION TO CONSTRUCT

11:30

STATESVILLE 704-878-5305 MOORESVILLE 704-664-5281

IMPROVEMENT PERMIT / CERTIFICATE OF COMPLETION / OPERATION PERMIT / EXISTING SYSTEM INSPECTION

PROPERTY DESCRIPTION NO. 065826 DATE 5/8/97 TAX MAP NO. 4649344669

OWNER OR CONTRACTOR AVERY TUCKER Watershed: ☑ Yes ☐ No

ADDRESS 415 W. AVENUE TROUTMAN NC 28166 PHONE: Business _____ Home 528-6396

LOCATION 150W - TR PERTH RD - TR FERN HILL ON CORNER OF ANGEL RD & FERN HILL - ON RT * AWAY FROM LAKE*

SUBDIVISION — BLOCK / SECTION — LOT — LOT AREA — SITE CLASS. PS DESIGN FLOW 360GPD L.T.A.R. 36GPD/FT

Septic Tank: 1000 Gallons; STB 1012 Date 3/18/97

Pump Tank: _____ Gallons; PT _____ Date _____

Pump Make: _____ Model _____ Serial No. _____

Nitrification Field: No Fields 1 Square Feet 1200 Linear Feet 400

No Lines 5 Trench Width 36" Max Trench Bottom Depth 36" Gravel Depth 12"

☑ New System ☐ Repair System Type: I (II) III, IV, V, VI

System Description: GRAVITY CONVENTIONAL

Repair System Description: _____

Maintenance Agreement Required: ☐ Yes ☑ No

☐ House/Mod. Home ☑ Mobile Home ☐ Business ☐ Other

No. Bedrooms 3 No. Bathrooms 2 No. Employees ____


☐ Slab ☑ Crawl Space ☐ Basement w/plumbing ☐ Basement wo/plumbing

Water Supply: ☑ Individual ☐ Community ☐ Public


Comments:

Comments:

INITIAL SITE SKETCH

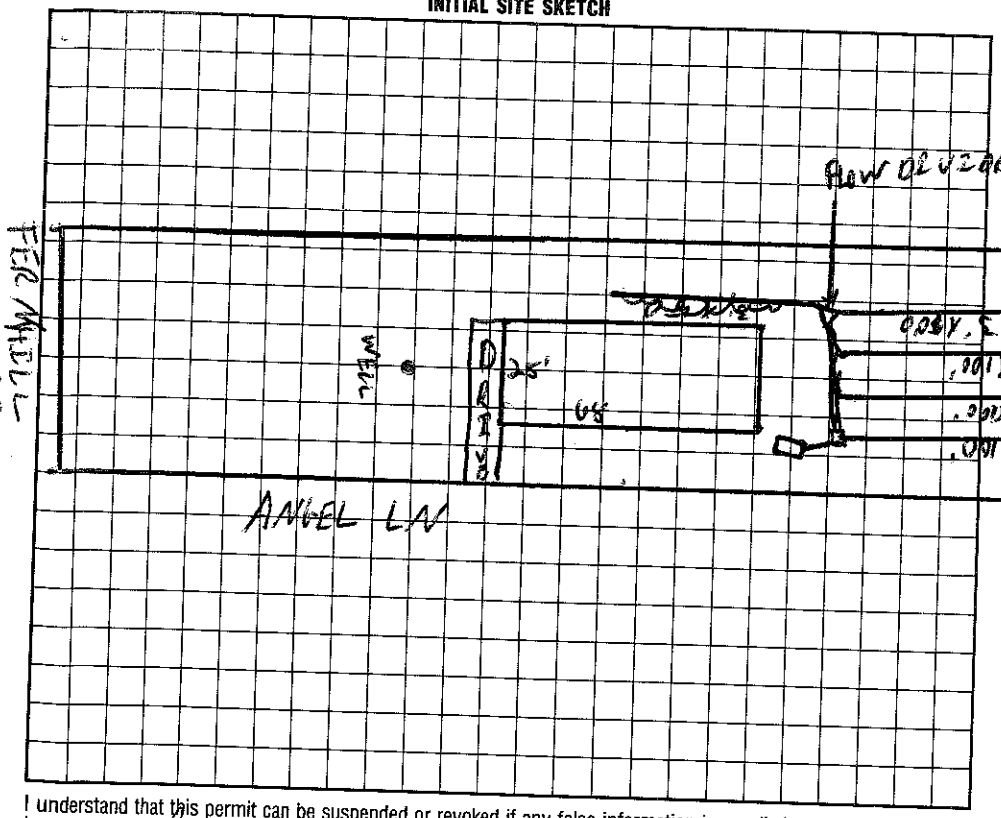

AS BUILT SKETCH

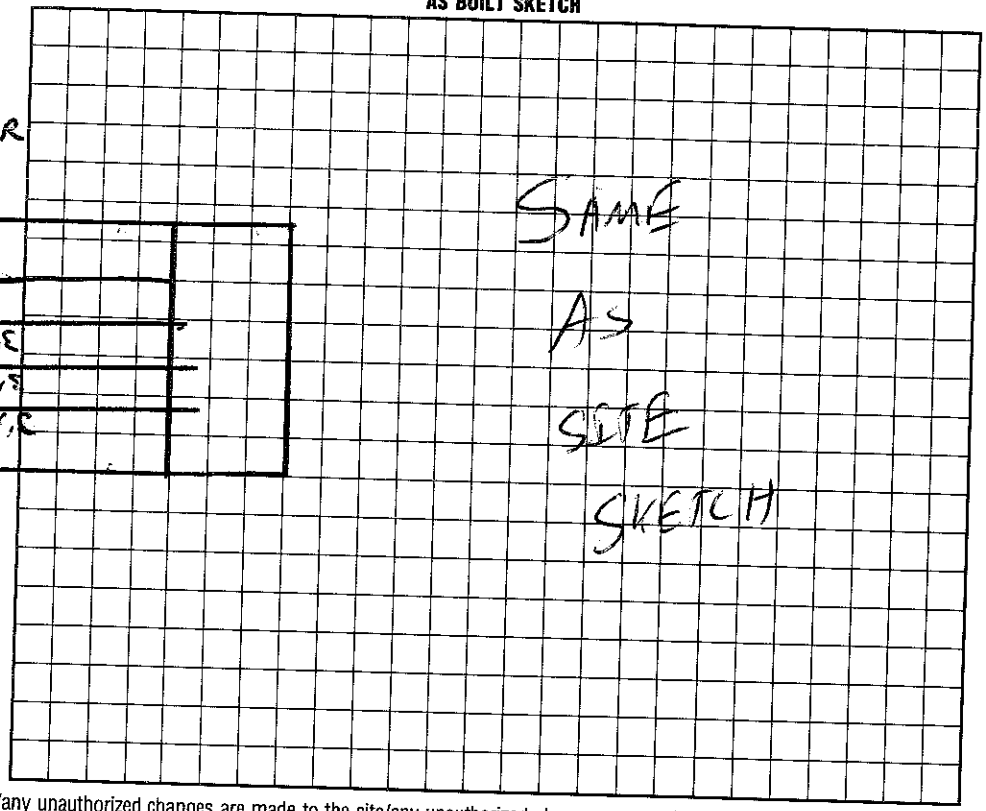

I understand that this permit can be suspended or revoked if any false information is supplied toward securing the permit/any unauthorized changes are made to the site/any unauthorized changes are made in the installation of the system. Improvement Permit is valid for 60 months from date of issuance.

Signed: _____

Improvement Permit by: C. [illegible] date 5/8/97

AUTHORIZATION TO CONSTRUCT ~~Existing System Inspection by:~~ C. [illegible] date 5/8/97

Installed by: A-1 BACKHOE

Certificate of Completion by: _____ date _____

Operation Permit by: C. [illegible] date 5/13/97

HEALTH DEPT. COPY: WHITE INSPECTION COPY (FINAL): GREEN OWNER COPY (FINAL): YELLOW INSPECTION COPY (INITIAL): PINK OWNER COPY (INITIAL): GOLD