IREDELL COUNTY HEALTH DEPARTMENT

Auth. extension to Construct

STATESVILLE 704-878-5305 MOORESVILLE 704-664-5281

IMPROVEMENT PERMIT / ~~CERTIFICATE OF COMPLETION~~ / OPERATION PERMIT / EXISTING SYSTEM INSPECTION

PROPERTY DESCRIPTION NO. 06789 DATE 8/5/97 TAX MAP NO. 4649345515 Watershed: ☐ Yes ☒ No

OWNER OR CONTRACTOR ~~Author~~ McKinley Dalcoe PHONE: Business Home 526-6356

ADDRESS 237 Fern Hill Rd Troutman NC 28166

LOCATION Peth Rd N TR FernHill to on (R) just past Angel Rd. 241 Fern Hill

SUBDIVISION No BLOCK / SECTION LOT LOT AREA SITE CLASS. DESIGN FLOW 360 L.T.A.R. .3

Septic Tank: 1000 Gallons; STB 821 Date 11/28/97

Pump Tank: 1000 Gallons; PT 40 Date 11/1/97

Pump Make: Zoeller Model N53C Serial No. 9/4/96

Nitrification Field: No Fields 1 Square Feet 900* Linear Feet 300*

No Lines 4 Trench Width 36" Max Trench Bottom Depth 36" Gravel Depth SAND.

☒ New System ☐ Repair System Type: I, II, (III), IV, V, VI

System Description: Presman-Ch. Plastic *

Repair System Description: SAME

Maintenance Agreement Required: ☐ Yes ☒ No

☒ House/Mod. Home No. Bedrooms 3

☐ Mobile Home No. Bathrooms 2

☐ Business No. Employees

☐ Other


☐ Slab ☒ Crawl Space ☐ Basement w/plumbing ☐ Basement wo/plumbing

Water Supply: ☒ Individual ☐ Community ☐ Public


Comments: * 25% square reduction due to Ch. Plastic use for drainfield material.

Comments:

INITIAL SITE SKETCH

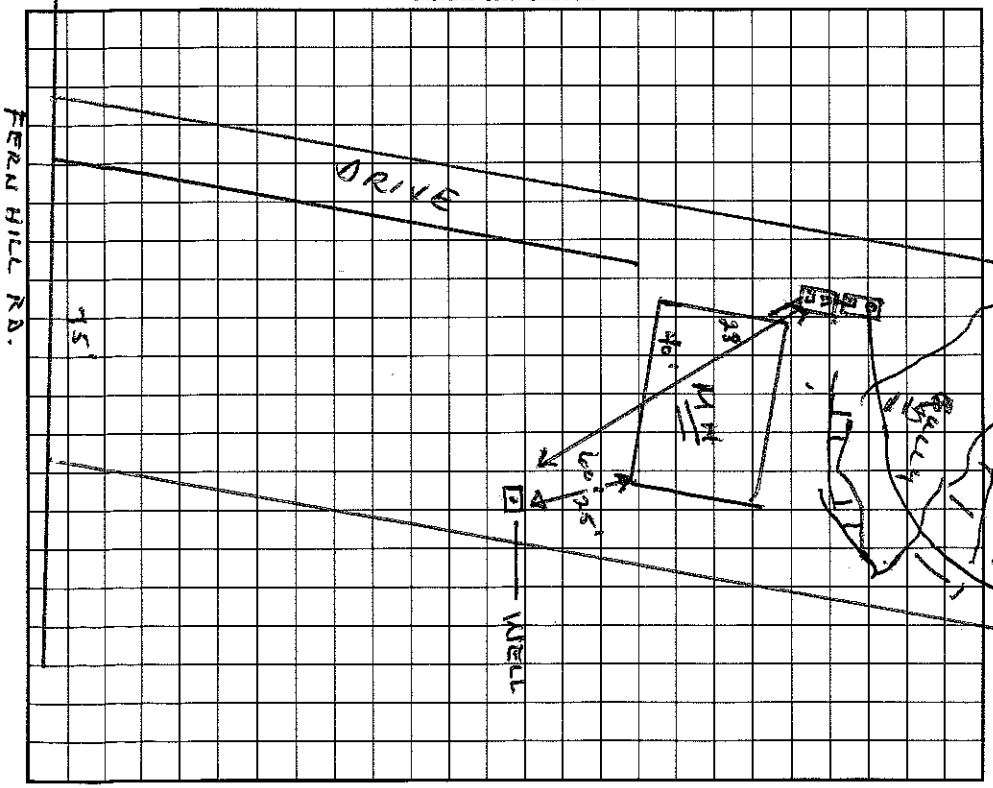

AS BUILT SKETCH

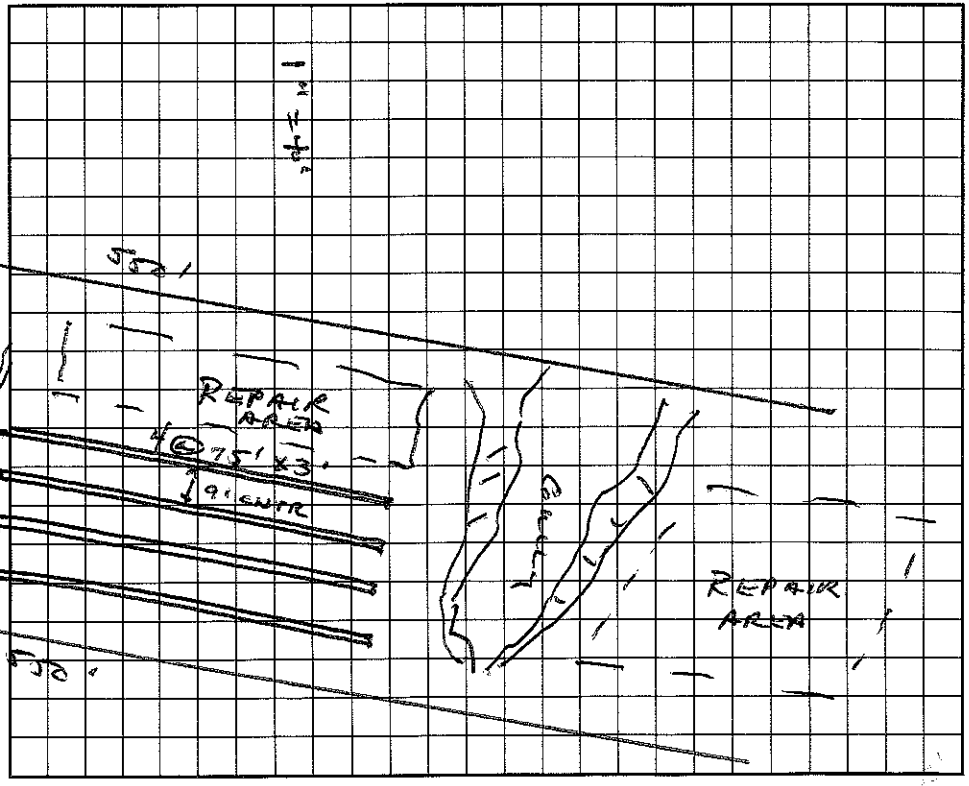

I understand that this permit can be suspended or revoked if any false information is supplied toward securing the permit/any unauthorized changes are made to the site/any unauthorized changes are made in the installation of the system. Improvement Permit is valid for 60 months from date of issuance.

Signed: McKinley Dalcoe Installed by: D+M Enterprises

Improvement Permit by: Wesley Sparks R.S. date 8/5/97

Certificate of Completion by: date

~~Existing System Inspection by:~~ Wesley Sparks R.S. date 8/5/97 Operation Permit by: date 3/3/98

HEALTH DEPT. COPY: WHITE INSPECTION COPY (FINAL): GREEN OWNER COPY (FINAL): YELLOW INSPECTION COPY (INITIAL): PINK OWNER COPY (INITIAL): GOLD