4649 35 1322

IREDELL COUNTY HEALTH DEPARTMENT

AUTH. TO CONSTRUCT

STATESVILLE 704-878-5305 MOORESVILLE 704-664-5281

IMPROVEMENT PERMIT / ~~CERTIFICATE OF COMPLETION~~ / OPERATION PERMIT / EXISTING SYSTEM INSPECTION

PROPERTY DESCRIPTION NO. 24250 DATE 10/1/96 TAX MAP NO. 25-A-46 Watershed: ☑ Yes ☐ No

OWNER OR CONTRACTOR BETTY JEAN LEACH PHONE: Business _____ Home 528-9883

ADDRESS 301 FERN HILL RD - TROUTMAN NC 28166

LOCATION " " " - PERTH RD N - TR FERN HILL RD - 301 - ON RT

SUBDIVISION _____ BLOCK / SECTION _____ LOT _____ LOT AREA _____ SITE CLASS. PS DESIGN FLOW 360 GPD L.T.A.R. EXISTING

Septic Tank: _____ Gallons; STB 794 Date 7/17/96

Pump Tank: _____ Gallons; PT _____ Date _____

Pump Make: _____ Model _____ Serial No. _____

Nitrification Field: No Fields 1 Square Feet ~~600~~ 900 Linear Feet ~~200~~ 300

No Lines 3 Trench Width 36" Max Trench Bottom Depth 36" Gravel Depth _____

☑ New System ☐ Repair System Type: I, II, III, IV, V, VI

System Description: GRAVITY CONVENTIONAL

Repair System Description: _____

Maintenance Agreement Required: ☐ Yes ☑ No

☑ House/Mod. Home No. Bedrooms 3

☐ Mobile Home No. Bathrooms 2

☐ Business No. Employees _____

☐ Other _____

Water Supply: ☑ Individual ☐ Community ☐ Public


☐ Slab ☑ Crawl Space ☐ Basement w/plumbing ☐ Basement wo/plumbing

Comments: KEEP [redacted] 5' FROM SYSTEM [redacted] (MH)

Comments: Well abandoned with concrete by D. Helder

backfilled as shown.

INITIAL SITE SKETCH

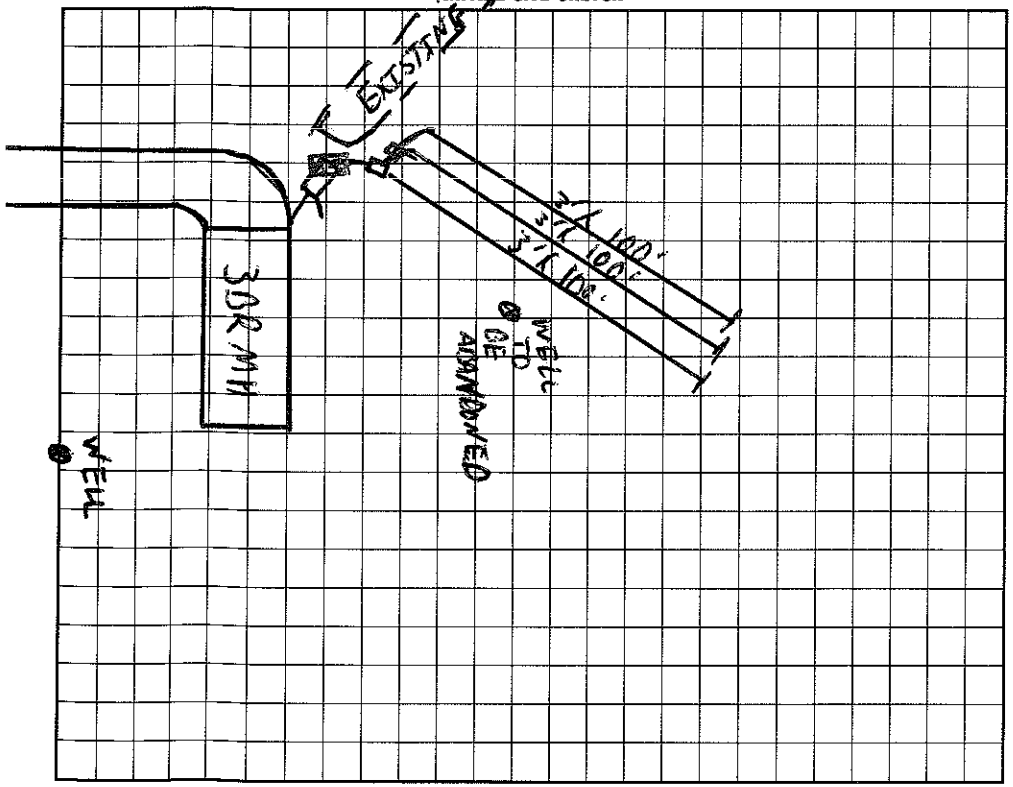

AS BUILT SKETCH

I understand that this permit can be suspended or revoked if any false information is supplied toward securing the permit/any unauthorized changes are made to the site/any unauthorized changes are made in the installation of the system.

Signed: Dennis Dellinger

Installed by: Dennis Helder

Improvement Permit by: C. Rob Green EHSP date 10/1/96

AUTHORIZATION TO CONSTRUCT

Existing System Inspection by: C. Rob Green EHSP date 10/1/96

Certificate of Completion by: _____ date _____

Operation Permit by: Wesley Sparks RS. date 10/10/96

HEALTH DEPT. COPY: WHITE INSPECTION COPY (FINAL): GREEN OWNER COPY (FINAL): YELLOW INSPECTION COPY (INITIAL): PINK OWNER COPY (INITIAL): GOLD