IREDELL COUNTY HEALTH DEPARTMENT

STATESVILLE 704-878-5305 ∅ MOORESVILLE 704-664-5281

IMPROVEMENT PERMIT / AUTHORIZATION TO CONSTRUCT / OPERATION PERMIT / EXISTING SYSTEM INSPECTION

PERMIT# 107802 PIN# 4649-37-4313 DATE 8/2/02

OWNER OR CONTRACTOR Lee McCoy PHONE: Business _____ Home 704-528-0609

ADDRESS 125 Old Cartway Drive Troutman NC 28166

LOCATION Perth, TR Fern Hill, TL Carlyle, TR Old Cartway, bear Left, House on Rt

SUBDIVISION _____ BLOCK / SECTION _____ LOT _____ LOT AREA 0.44AC SITE CLASS PS DESIGN FLOW (3) L.T.A.R. _____

Septic Tank: Existing Gallons; STB _____ Date _____
Pump Tank: _____ Gallons; PT _____ Date _____
Pump Make: _____ Model _____ Serial No. _____
Nitrification Field: No Fields ___ Square Feet _____ Linear Feet _____
No Lines _____ Trench Width _____ Max Trench Bottom Depth _____ Gravel Depth _____

☐ New System ☐ Repair System Type: I (II) III IV V VI
System Description: Conventional-Existing
Repair System Description: _____
Maintenance Agreement Required: ☐ Yes ☒ No

☒ House/Mod. Home No. Bedrooms 1
☐ Mobile Home No. Bathrooms 1
☐ Business No. Employees ___
☐ Other _____

☐ Slab ☒ Crawl Space ☐ Basement w/plumbing ☐ Basement wo/plumbing


Water Supply: ☒ Individual ☐ Public ☐ Community

Comments:/Conditions:

Comments:/Conditions:
Expanding bedroom

INITIAL SITE SKETCH

AS BUILT SKETCH

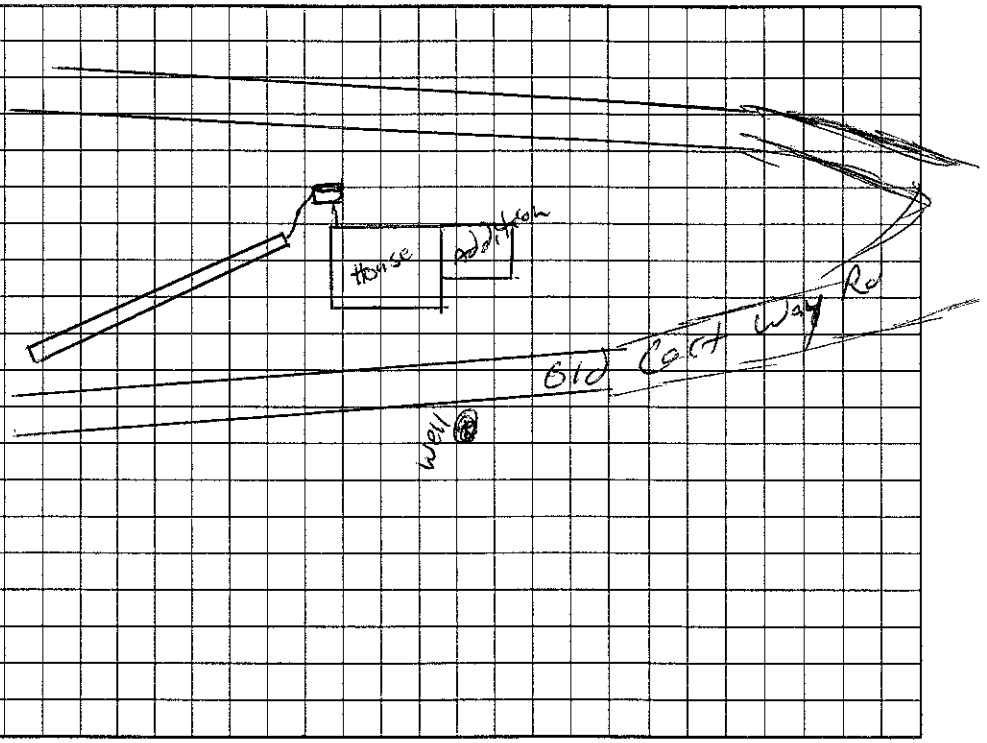

Permit can be suspended or revoked if any false information is supplied toward securing the permit/any unauthorized changes are made to the site/any unauthorized changes are made in the installation of the system. Improvement Permit with plat valid without expiration, Improvement Permit with site plan valid for sixty months. Authorization to Construct is valid for a period equal to that of Improvement Permit – not to exceed sixty months.

Signed: Lee O. McCoy date 8/2/02 Installed by: _____

Improvement Permit by: _____ date _____ Operation Permit by: _____ date _____

Authorization to Construct by: _____ date _____ Existing System Inspection by: _____ RS date 8/2/02

HEALTH DEPT. COPY: WHITE OWNER COPY (FINAL): YELLOW OWNER COPY (INITIAL): PINK