IREDELL COUNTY HEALTH DEPARTMENT

AUTHORIZATION TO CONSTRUCT

STATESVILLE 704-878-5305

4649381370

MOORESVILLE 704-664-5281

IMPROVEMENT PERMIT / ~~CERTIFICATE OF COMPLETION~~ / OPERATION PERMIT / EXISTING SYSTEM INSPECTION

PROPERTY DESCRIPTION NO. 23619 DATE 7/29/96 TAX MAP NO. 3F-A104 Pt of

OWNER OR CONTRACTOR ANTHONY MOORE PHONE: Business _____ Home 528-4506

ADDRESS PO Box 926 TROUTMAN

LOCATION PEATH RD N- TR FERN HILL - TL CARLYLE RD - ≈.5 MILES ON LEFT

SUBDIVISION — BLOCK / SECTION — LOT — LOT AREA +- 1.55AC SITE CLASS PS DESIGN FLOW 360GPD L.T.A.R. .3GPD/FT²

Watershed: ☑ Yes ☐ No WSIV-CA

Septic Tank: 1000 Gallons; STB 794 Date 6/14/96

Pump Tank: _____ Gallons; PT _____ Date _____

Pump Make: _____ Model _____ Serial No. _____

Nitrification Field: No Fields 1 Square Feet 1200 Linear Feet 400

No Lines 5 Trench Width 36" Max Trench Bottom Depth ~~24~~ 22"

☑ New System ☐ Repair System Type: I, II, III, IV, V, VI

System Description: GRAVITY

Repair System Description: PUMP PANEL

Maintenance Agreement Required: ☐ Yes ☑ No

Gravel Depth 12"

☐ Slab ☑ Crawl Space ☐ Basement w/plumbing ☐ Basement wo/plumbing

☐ House/Mod. Home ☑ Mobile Home ☐ Business ☐ Other


No. Bedrooms 3 No. Bathrooms 2 No. Employees ____

Water Supply: ☑ Individual ☐ Community ☐ Public


Comments: PROPETY NEEDS TO BE CLEARED AND SMOOTHED. LINES MAY BE CHANGED TO 4 @ 100' IF POSSIBLE

Comments:

INITIAL SITE SKETCH (NOT TO SCALE)

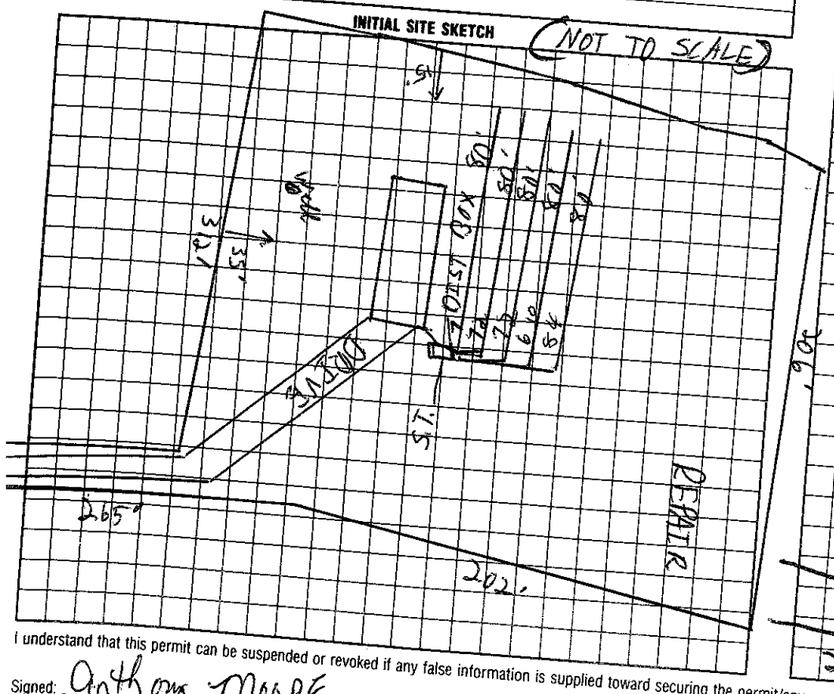

AS BUILT SKETCH E-Z LAY SYSTEM

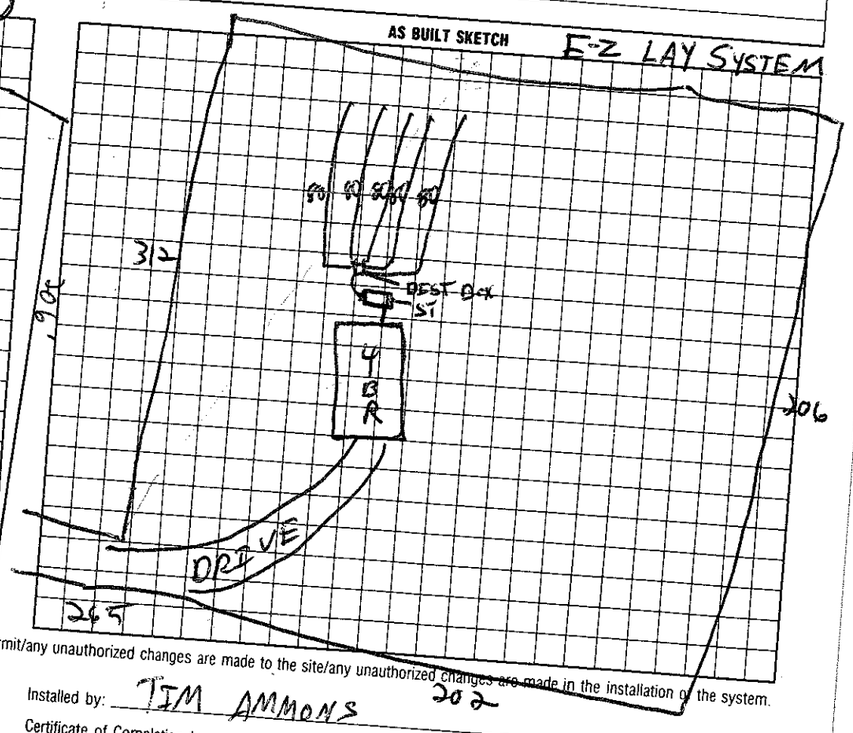

I understand that this permit can be suspended or revoked if any false information is supplied toward securing the permit/any unauthorized changes are made to the site/any unauthorized changes are made in the installation of the system.

Signed: Anthony Moore

Improvement Permit by: C. Barrington EHS date 7/29/96

~~Existing System Inspection~~ by: C. Barrington EHS date 7/29/96

Installed by: TIM AMMONS

Certificate of Completion by: _____ date _____

Operation Permit by: _____ date 8/26/96

HEALTH DEPT. COPY: WHITE INSPECTION COPY (FINAL): GREEN OWNER COPY (FINAL): YELLOW INSPECTION COPY (INITIAL): PINK OWNER COPY (INITIAL): GOLD

AUTHORIZATION TO CONSTRUCT IS VALID FOR 60 MONTHS FROM ISSUE DATE.