# IREDELL COUNTY HEALTH DEPARTMENT

STATESVILLE 704-878-5305 MOORESVILLE 704-664-5281

## IMPROVEMENT PERMIT / AUTHORIZATION TO CONSTRUCT / OPERATION PERMIT / EXISTING SYSTEM INSPECTION

PERMIT# N/A PIN# 4649388944 Hoober Gutierrez DATE 9-13-07

OWNER OR APPLICANT Ceila Caballero PHONE: Business 704-287-2969 Home

ADDRESS 310 Carlyle Rd. Troutman NC 28166

LOCATION Perth Rd N. TR Fernhill Rd TL Carlyle Rd on left past newer houses #310

SUBDIVISION ——— BLOCK / SECTION ——— LOT ——— LOT AREA SITE CLASS. PS DESIGN FLOW 360gpd L.T.A.R. .3

Septic Tank: 1000 Gallons; STB 312 Date 12-4-06

Pump Tank: Gallons; PT Date

Pump Make: Model Serial No.

Nitrification Field: No Fields 1 Square Feet 800' Linear Feet 50'

No Lines 2 ~~Trench~~ Bed Width 16' Max Trench Bottom Depth 36" Gravel Depth 12"+ ☒ Gravity ☐ Pressure

☐ New System ☒ Repair ☐ Expansion System Type: (I) II III IV V VI

System Description: Gravity-Conventional

Repair System Description: Grav.-Convent/Bed

Maintenance Agreement Required: ☐ Yes ☒ No

☒ House/Mod. Home ☐ Mobile Home ☐ Business ☐ Other

No. Bedrooms 3 No. Persons No. Employees


Water Supply: ☒ Individual ☐ Public ☐ Community

☐ Slab ☒ Crawl Space ☐ Basement w/plumbing ☐ Basement wo/plumbing

Comments:/Conditions: * Initial system was probably Gravity-Conventional however Someone has now "straight piped" it to ditch. Keep Septic System 50ft from well & 5ft from PL.

Comments:/Conditions: Note: Install upper end of Drainfield at 36" trench bottom & higher end ~18" trench bottom then bring in good Clean of debris Fill For lower end of drainfield

INITIAL SITE SKETCH

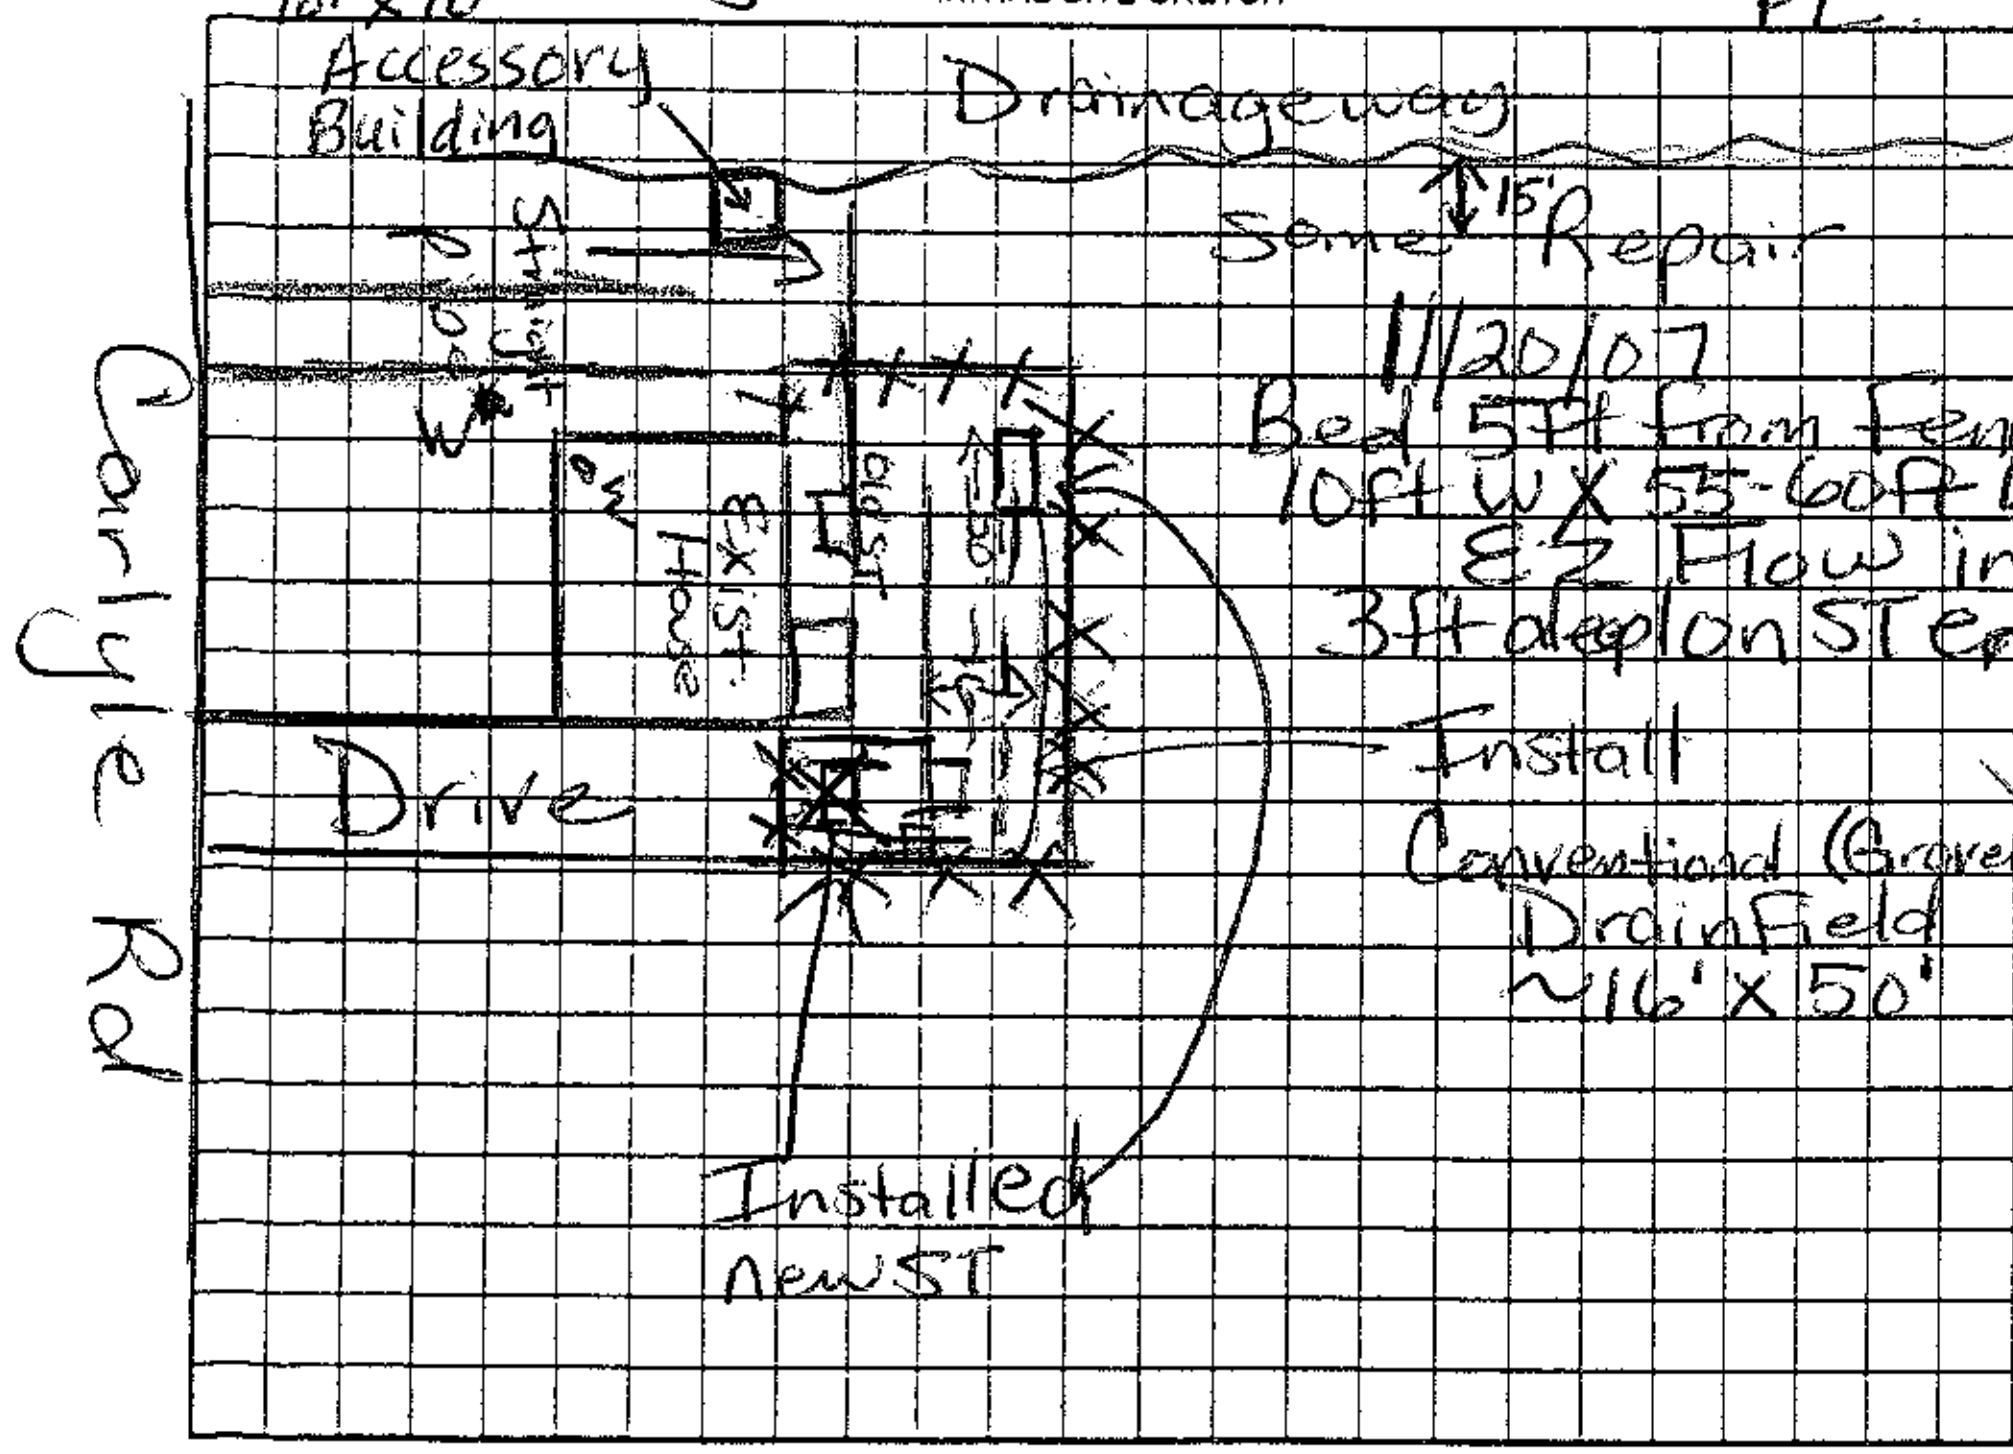


11/20/07
Bed 5ft from Fence
10ft W X 55-60ft L
EZ Flow installed
3ft deep on ST end & 5ft deep on other side

AS BUILT SKETCH

* Okay to use EZ Flow or Plastic Chambers for Drainfield but No Reduction will be given.

Properly abandoned Old ST

~2009 Property re-surveyed. Lot bigger than shown.

The proposed / existing Accessory Building addition does not appear to impact the existing septic system.

**NOTE: 10'x10' Shed

Mary Melville REHS

Date: 5-17-11

ICHD-Environmental Health Division

Permit can be suspended or revoked if any false information is supplied toward securing the permit/any unauthorized changes are made to the site/any unauthorized changes are made in the installation of the system. Improvement Permit with plat valid without expiration ☐ Improvement Permit with site plan valid for sixty months ☐ Authorization to Construct is valid for a period equal to that of Improvement Permit – not to exceed sixty months.

Signed: Ceila Caballero date 9-17-07 Installed by: Stanley Septic

Improvement Permit by: Maria H. Dolan RS date 9/13/07 Operation Permit by: Maria H. Dolan RS date 11/20/07

Authorization to Construct by: Maria H. Dolan RS date 9/13/07 Existing System Inspection by: date

HEALTH DEPT. COPY: WHITE OWNER COPY (FINAL): YELLOW OWNER COPY (INITIAL): PINK