IREDELL COUNTY HEALTH DEPARTMENT

STATESVILLE 704-878-5305 MOORESVILLE 704-664-5281

#1520

3 ac Rowan

IMPROVEMENT PERMIT / AUTHORIZATION TO CONSTRUCT / OPERATION PERMIT / EXISTING SYSTEM INSPECTION

PERMIT# 09/352 PIN# 4740203493 4649 39 4940 DATE April 19, 02

OWNER OR CONTRACTOR AH Inc // Spears Const. PHONE: Business Home

ADDRESS 450 Anchor Dr Salisbury N.C. 28144

LOCATION Perth Road N. TR Clontz Hill Rd. TR Ridge Creek TR Wiltshire TR Panther Creek on Right 134 E. Panther Creek

SUBDIVISION Wiltshire Creek BLOCK / SECTION LOT 44 LOT AREA .66Ac SITE CLASS. PS DESIGN FLOW 360gpd L.T.A.R. .3

Septic Tank: 1000 Gallons; STB 825 Date 4-30-02 ☑ New System ☐ Repair System Type: I. II. III. IV. V. VI

Pump Tank: 1000 Gallons; PT 302 Date 5-1-02 System Description: pm - Innovative - 25% Red.

Pump Make: Gould's Model PE31M Serial No. SD342727 Repair System Description: LP Innovative

Nitrification Field: No Fields 1 Square Feet 900 Linear Feet 300 Maintenance Agreement Required: ☐ Yes ☑ No initially

No Lines 3 Trench Width 36" Max Trench Bottom Depth 36" Gravel Depth NA

☑ House/Mod. Home No. Bedrooms 3 ☐ Mobile Home No. Bathrooms 2 ☐ Business No. Employees ☐ Other

☐ Slab ☑ Crawl Space ☐ Basement w/plumbing ☐ Basement wo/plumbing


Water Supply: ☑ Individual ☐ Public ☐ Community

Comments/Conditions:

Comments/Conditions: Check for rope on pump Before Final
Tanks, lines & pressure Checked 7/23/02

1"=50'

INITIAL SITE SKETCH

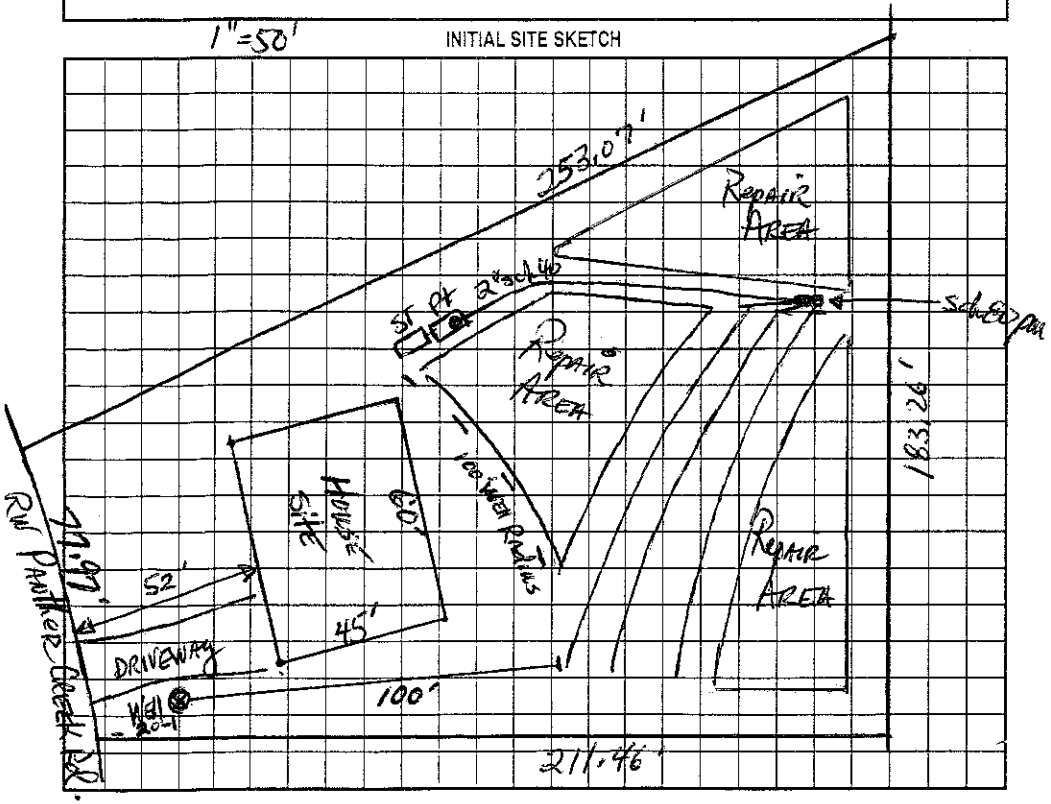

AS BUILT SKETCH

Installed 4 Plastic Chambers as Shown

Permit can be suspended or revoked if any false information is supplied toward securing the permit/any unauthorized changes are made to the site/any unauthorized changes are made in the installation of the system. Improvement Permit with plat valid without expiration. Improvement Permit with site plan valid for sixty months. Authorization to Construct is valid for a period equal to that of Improvement Permit – not to exceed sixty months.

Signed: date 4/24/02 Installed by: Rowan Septic

Improvement Permit by: RS date 4-19-02 Operation Permit by: Wesley Sparks R.S. date 9/11/02

Authorization to Construct by: RS date 4-19-02 Existing System Inspection by: date

HEALTH DEPT. COPY: WHITE OWNER COPY (FINAL): YELLOW OWNER COPY (INITIAL): PINK