4649 397 7033

IREDELL COUNTY HEALTH DEPARTMENT

STATESVILLE 704-878-5305 MOORESVILLE 704-664-5281

IMPROVEMENT PERMIT / CERTIFICATE OF COMPLETION / OPERATION PERMIT / EXISTING SYSTEM INSPECTION

PROPERTY DESCRIPTION NO. 19344 DATE 6/12/95 TAX MAP NO. 3G 1-A-19 Watershed: ☐ Yes ☒ No

OWNER OR CONTRACTOR Rose Boyd PHONE: Business _____ Home 663-6588

ADDRESS 347 W 11th Cleveland St. Mooresville NC. 28115

LOCATION Carlyle Rd on (R) before church on (L) coming from Flower Home Loop.

SUBDIVISION _____ BLOCK / SECTION _____ LOT _____ LOT AREA _____ SITE CLASS. PS DESIGN FLOW 360 L.T.A.R. .3

Septic Tank: 1000 Gallons; STB 794 Date 5/30/95

Pump Tank: _____ Gallons; PT _____ Date _____

Pump Make: _____ Model _____ Serial No. _____

Nitrification Field: No Fields 1 Square Feet 1200 Linear Feet 300 (400)

No Lines 4 Trench Width 36" Max Trench Bottom Depth 32" Gravel Depth N/A

☒ New System ☐ Repair System Type: I, II, ☒ III, IV, V, VI

System Description: GRAVITY INFILTRATOR

Repair System Description: GRAVITY PANEL

Maintenance Agreement Required: ☒ Yes ☐ No

☐ Slab ☒ Crawl Space ☐ Basement w/plumbing ☐ Basement wo/plumbing

☐ House/Mod. Home No. Bedrooms 3

☒ Mobile Home No. Bathrooms 2

☐ Business No. Employees _____


☐ Other _____

Water Supply: ☒ Individual ☐ Community ☐ Public


Comments: ~~X~~ 25% reduction for use of INFILTRATOR
Trench depth no greater than 32" to trench bottom.

Comments:

INITIAL SITE SKETCH

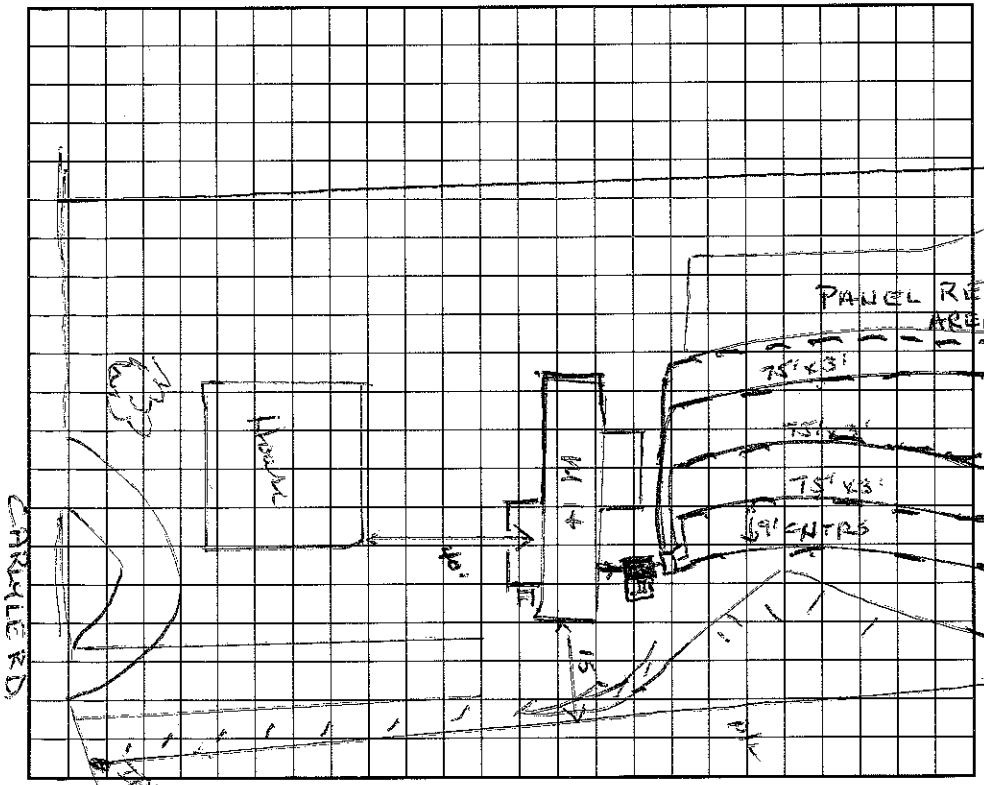

AS BUILT SKETCH

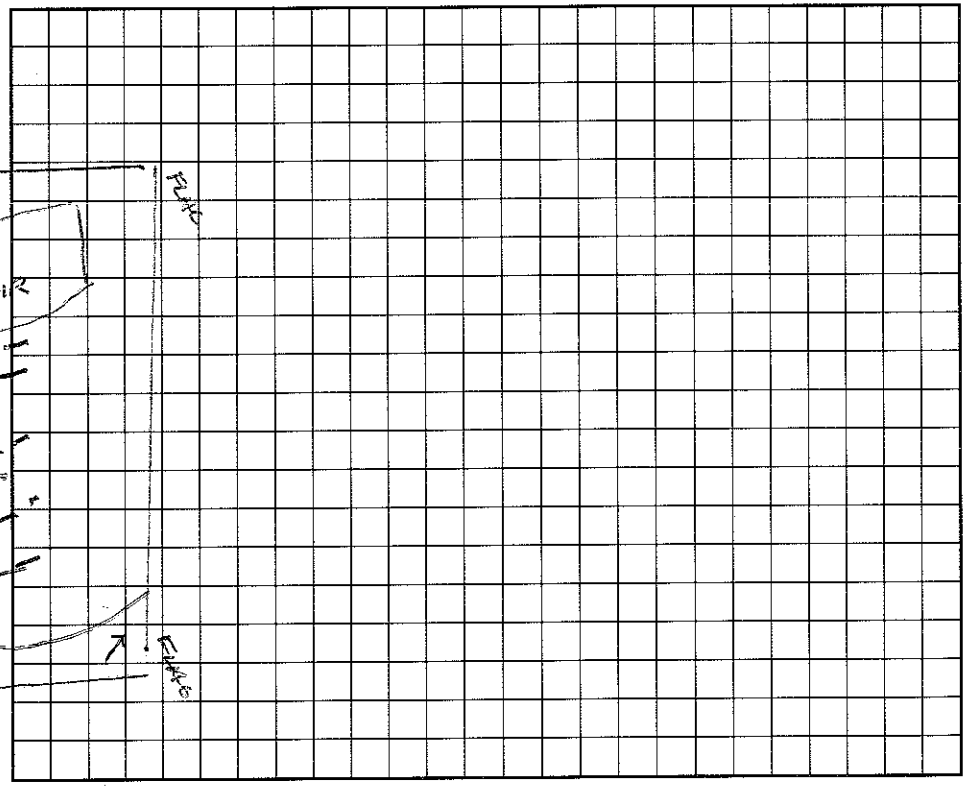

I understand that this permit can be suspended or revoked if any false information is supplied toward securing the permit/any unauthorized changes are made to the site/any unauthorized changes are made in the installation of the system. Improvement Permit is valid for 60 months from date of issuance.

Signed: Rose Boyd

Improvement Permit by: Wesley Sparks R.S. date 6/12/95

Existing System Inspection by: _____ date _____

Installed by: Dennis Gilbert

Certificate of Completion by: Wesley Sparks R.S. date 8/16/95

Operation Permit by: _____ date _____

HEALTH DEPT. COPY: WHITE INSPECTION COPY (FINAL): GREEN OWNER COPY (FINAL): YELLOW INSPECTION COPY (INITIAL): PINK OWNER COPY (INITIAL): GOLD