2130

# IREDELL COUNTY HEALTH DEPARTMENT

STATESVILLE 704-878-5305 MOORESVILLE 704-664-5281

## IMPROVEMENT PERMIT / AUTHORIZATION TO CONSTRUCT / OPERATION PERMIT / EXISTING SYSTEM INSPECTION

PERMIT# 103175 PIN# 4649-39-8520 DATE 11/7/01

OWNER OR CONTRACTOR Pamela Smith PHONE: Business _____ Home 709-657-0960

ADDRESS 290 Carlyle Rd Troutman NC 28166

LOCATION 21N, TL Flowerhouse, TL Carlyle 1 1/4 mile on Rt off the Rd.

SUBDIVISION _____ BLOCK / SECTION _____ LOT _____ LOT AREA _____ SITE CLASS. PS DESIGN FLOW 360 L.T.A.R. 0.3

Septic Tank: 1000 Gallons; STB 794 Date 3/7/00
Pump Tank: _____ Gallons; PT _____ Date _____
Pump Make: _____ Model _____ Serial No. _____
Nitrification Field: No Fields 1 Square Feet 900 Linear Feet 300
No Lines 4@75' Trench Width 36" Max Trench Bottom Depth 36" Gravel Depth —

☒ New System ☐ Repair System Type: I, II, (III), IV, V, VI
System Description: Gravity 25% Reduc
Repair System Description: LP Panel
Maintenance Agreement Required: ☐ Yes ☒ No

☒ House/Mod. Home No. Bedrooms 3
☐ Mobile Home No. Bathrooms 3
☐ Business No. Employees _____
☐ Other _____


Water Supply: ☒ Individual ☐ Public ☐ Community

☐ Slab ☒ Crawl Space ☐ Basement w/plumbing ☐ Basement wo/plumbing

Comments:/Conditions:

To Carlyle Rd

INITIAL SITE SKETCH 1" = 40'

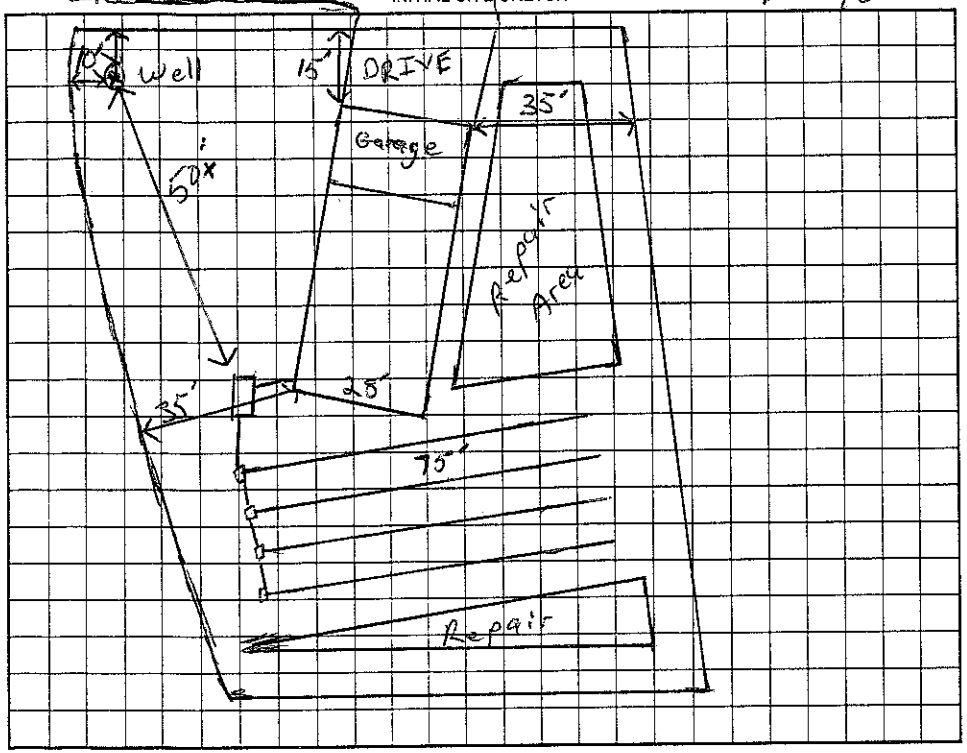


Comments:/Conditions:

AS BUILT SKETCH

Permit can be suspended or revoked if any false information is supplied toward securing the permit/any unauthorized changes are made to the site/any unauthorized changes are made in the installation of the system. Improvement Permit with plat valid without expiration. Improvement Permit with site plan valid for sixty months. Authorization to Construct is valid for a period equal to that of Improvement Permit – not to exceed sixty months.

Signed: Pamela Smith date 11/7/01

Improvement Permit by: RSI date 11/7/01

Authorization to Construct by: RSI date 11/7/01

Installed by: Tucker Grading

Operation Permit by: RS date 3/26/02

Existing System Inspection by: _____ date _____

HEALTH DEPT. COPY: WHITE OWNER COPY (FINAL): YELLOW OWNER COPY (INITIAL): PINK