4604944024?

IREDELL COUNTY HEALTH DEPARTMENT

STATESVILLE 704-878-5305 MOORESVILLE 704-664-5281

IMPROVEMENT PERMIT / CERTIFICATE OF COMPLETION / OPERATION PERMIT / EXISTING SYSTEM INSPECTION

PROPERTY DESCRIPTION NO. [redacted] 19385 DATE 10/11/94 TAX MAP NO. 2R A 31 Watershed: ☐ Yes ☒ No

OWNER OR CONTRACTOR Kevin Dunmon PHONE: Business _____ Home 788-9557

ADDRESS Rt 1 Box 2153 Mooresville, NC. 28115

LOCATION Rankin Hill Rd TR FernHill Rd. Lot on (R) ~ 2 mile on (R)

SUBDIVISION _____ BLOCK / SECTION _____ LOT _____ LOT AREA 1.6 ACRES SITE CLASS. P DESIGN FLOW 240 L.T.A.R. .3

Septic Tank: 1000 Gallons; STB 794 Date 6/12/94
Pump Tank: _____ Gallons; PT _____ Date _____
Pump Make: _____ Model _____ Serial No. _____
Nitrification Field: No Fields 1 Square Feet 800 Linear Feet 266
No Lines 3 Trench Width 36" Max Trench Bottom Depth 36" Gravel Depth 12"

☒ New System ☐ Repair System Type: I (II) III, IV, V, VI
System Description: DIST. BOX - CONV.
Repair System Description: _____
Maintenance Agreement Required: ☐ Yes ☒ No

☒ House/Mod. Home ☐ Mobile Home ☐ Business ☐ Other _____
No. Bedrooms 2 No. Bathrooms 1 No. Employees _____


☐ Slab ☒ Crawl Space ☐ Basement w/plumbing ☐ Basement wo/plumbing

Water Supply: ☒ Individual ☐ Community ☐ Public

Comments: Keep on contour in direction shown.
Well must be located in position shown.

Comments: Installed essentially as shown on Imp. Permit

INITIAL SITE SKETCH

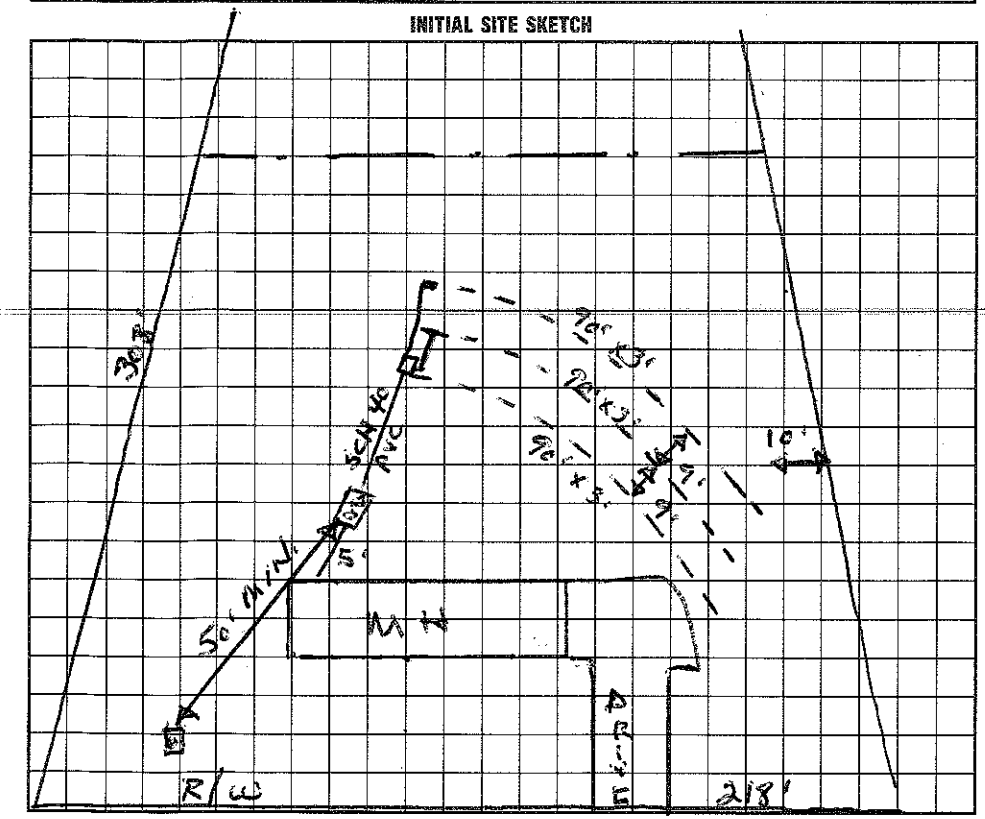

AS BUILT SKETCH

I understand that this permit can be suspended or revoked if any false information is supplied toward securing the permit/any unauthorized changes are made to the site/any unauthorized changes are made in the installation of the system. Improvement Permit is valid for 60 months from date of issuance.

Signed: Kevin Dunmon

Improvement Permit by: Wesley Sparks RS. date 10/11/94

Existing System Inspection by: _____ date _____

Installed by: Kevin Dunmon

Certificate of Completion by: Wesley Sparks RS. date 11/15/94

Operation Permit by: _____ date _____

HEALTH DEPT. COPY: WHITE INSPECTION COPY (FINAL): GREEN OWNER COPY (FINAL): YELLOW INSPECTION COPY (INITIAL): PINK OWNER COPY (INITIAL): GOLD