IREDELL COUNTY HEALTH DEPARTMENT

STATESVILLE 704-878-5305 MOORESVILLE 704-664-5281

IMPROVEMENT PERMIT / AUTHORIZATION TO CONSTRUCT / OPERATION PERMIT / EXISTING SYSTEM INS.

(2.00)

PERMIT# 82829 PIN# ~~4649449335~~ 4649 44 9335 DATE 7/20/

OWNER OR CONTRACTOR PHILIP CARNELL PHONE: Business _____ Home 528-1496

ADDRESS 124 SORREL LN TROUTMAN NC 28166

LOCATION PERTHRO - TR FERNHILL - ¼ MILE ON RT

SUBDIVISION DANIEL PLATT BLOCK / SECTION _____ LOT 2 LOT AREA 6.15AC SITE CLASS. PS DESIGN FLOW 240 L.T.A.R. .3

Septic Tank: 1000 Gallons; STB 1012 Date 6/20/99
Pump Tank: _____ Gallons; PT _____ Date _____
Pump Make: _____ Model _____ Serial No. _____
Nitrification Field: No Fields 1 Square Feet 533 Linear Feet 270
No Lines 4@67' Trench Width 36" Max Trench Bottom Depth 24" Gravel Depth 12"

☑ New System ☐ Repair System Type: I, II, III, IV, V, VI
System Description: GRAVITY CONVENTIONAL
Repair System Description: SAME
Maintenance Agreement Required: ☐ Yes ☑ No

☐ House/Mod. Home ☑ Mobile Home ☐ Business ☐ Other
No. Bedrooms 2 No. Bathrooms 2 No. Employees _____


☐ Slab ☑ Crawl Space ☐ Basement w/plumbing ☐ Basement wo/plumbing

Water Supply: ☑ Individual ☐ Public ☐ Community


Comments/Conditions: Drop boxes installed. Riser & filter installed. Lower line deeper.

Comments:/Conditions:

INITIAL SITE SKETCH

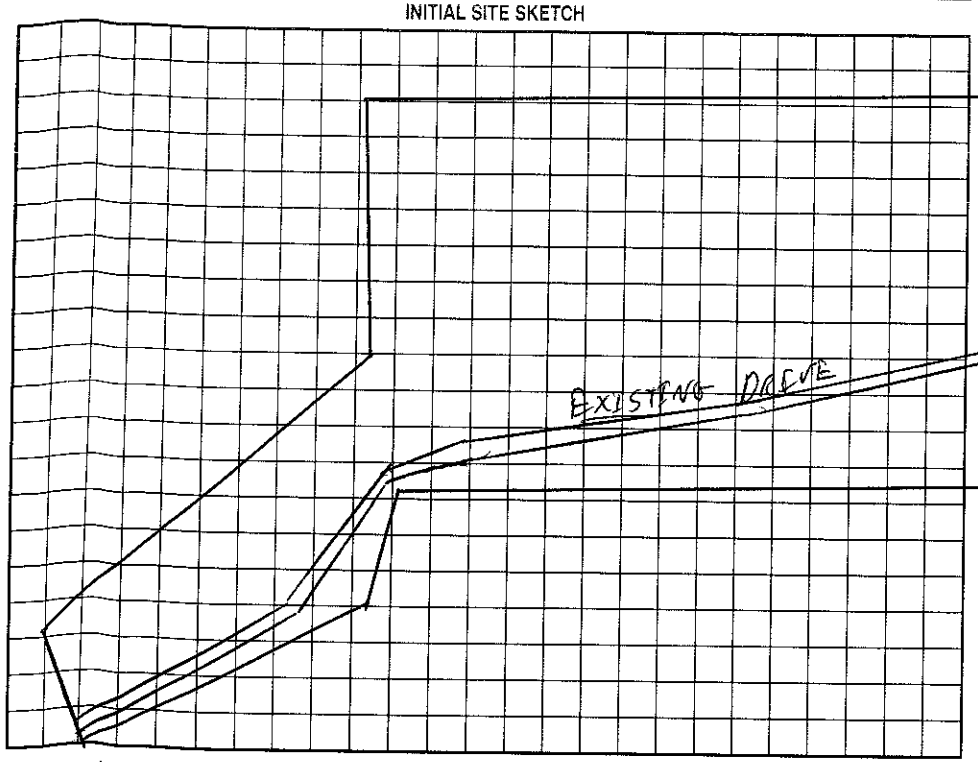

AS BUILT SKETCH

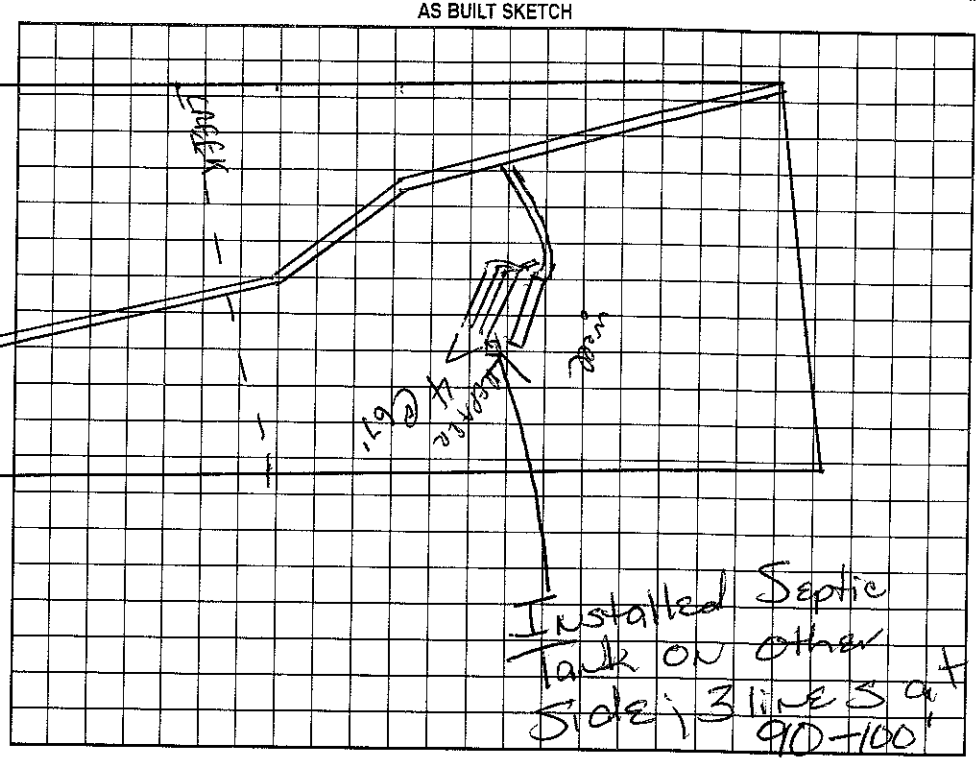

Permit can be suspended or revoked if any false information is supplied toward securing the permit/any unauthorized changes are made to the site/any unauthorized changes are made in the installation of the system. Improvement Permit with plat valid without expiration. Improvement Permit with site plan valid for sixty months. Authorization to Construct is valid for a period equal to that of Improvement Permit – not to exceed sixty months.

Signed: _____ date 7-29-99 Installed by: A-1 Backhoe

Improvement Permit by: C. _____ RS date 7/28/99 Operation Permit by: _____ RS date 8/23/99

Authorization to Construct by: C. _____ RS date 7/28/99 Existing System Inspection by: _____ date 8/23/99

HEALTH DEPT. COPY: WHITE OWNER COPY (FINAL): YELLOW OWNER COPY (INITIAL): PINK