11:30

IREDELL COUNTY HEALTH DEPARTMENT

STATESVILLE 704-878-5305 ✓MOORESVILLE 704-664-5281

IMPROVEMENT PERMIT / AUTHORIZATION TO CONSTRUCT / OPERATION PERMIT / EXISTING SYSTEM INSPECTION

PERMIT # 174483 PIN # 4649-48-1264 DATE 10-8-12

OWNER or APPLICANT MARIA ABERNATHY PHONE: Business 704-928-8614 Home:

OWNER or APPLICANT ADDRESS 114 TEROSS LN TROUTMAN

LOCATION / DIRECTIONS 21N, TL FLOWERHOUSE LP, TL CARLYLE, TL TEROSS, C END

SUBDIVISION BLOCK / SECTION LOT # LOT AREA 1.351AC DESIGN FLOW 600 L.T.A.R. .3

Septic Tank * 1500 Gallons: STB AA44 Date 3-29-13

Pump Tank Gallons: P T Date

Pump Make Model Serial #

Nitrification Field No Fields 1 No Lines 4 Linear Feet 300'

Trench Width 36" Max. Trench Bottom Depth 36" Gravel Depth —

☐ New System ☐ Repair ☒ Expansion System Type I II (III) IV V VI

System Description: 25% REDUCTION

Repair System Description: PM 25%

Maintenance Agreement Required ☐ YES ☒ NO

☒ GRAVITY ☐ PRESSURE

☒ Residence No. Bedrooms 5

☐ Business No. Persons

☐ Other No. Employees

☐ Slab ☒ Crawl Space


☐ Basement w/plumbing ☐ Basement w/o plumbing

Water Supply: ☒ Private ☐ Public ☐ Community


Comments / Conditions

Comments / Conditions

INITIAL SITE SKETCH

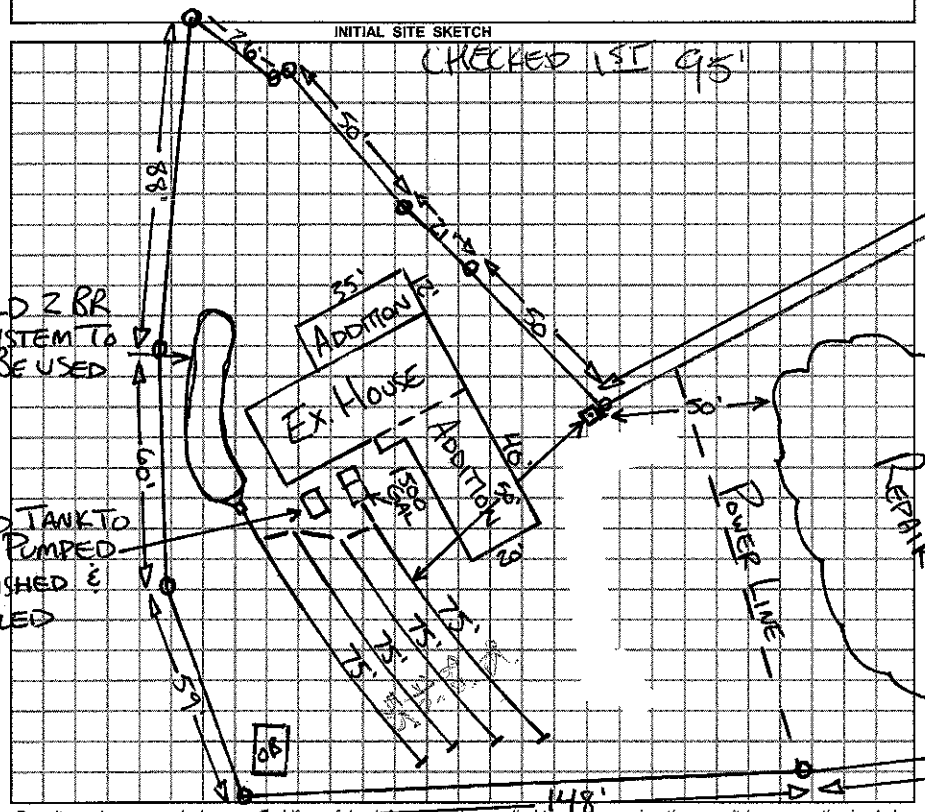

AS-BUILT SKETCH

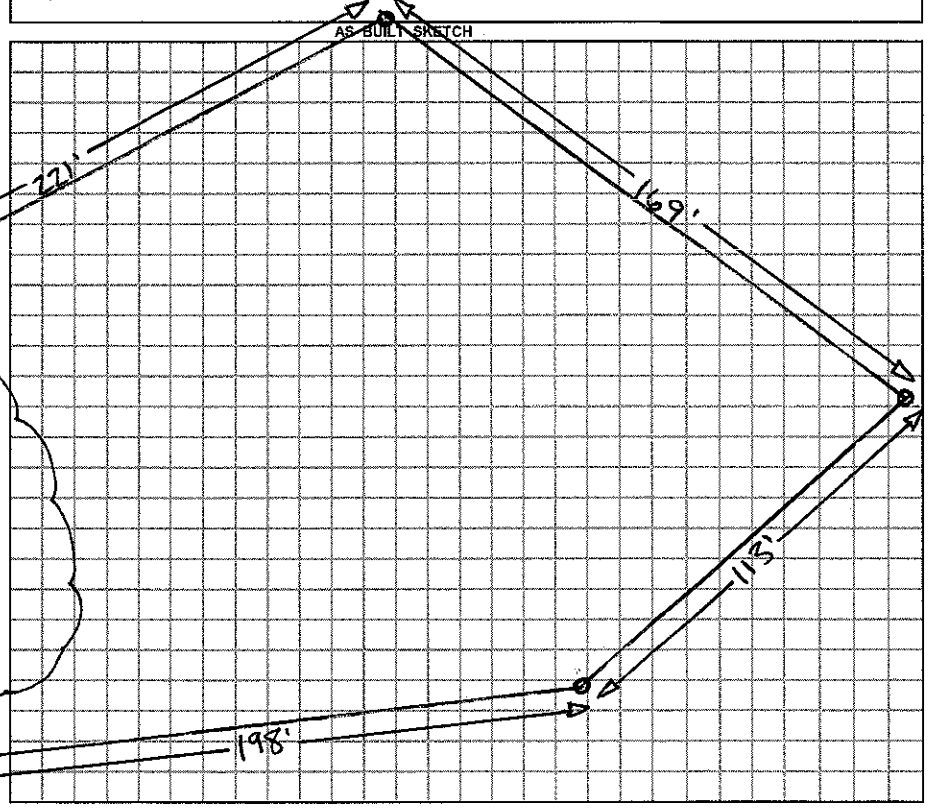

Permit can be suspended or revoked if any false information is supplied toward securing the permit / any unauthorized changes are made to the site / any unauthorized changes are made in the installation of the system.

☐ *IMPROVEMENT PERMIT w / plat valid without expiration.* ☒ *IMPROVEMENT PERMIT w / site plan valid for 60 mos.* ☒ *AUTHORIZATION TO CONSTRUCT valid for period equal to IMPROVEMENT PERMIT-not to exceed 60 mo.*

Owner / Applicant Signature: Maria Abernathy Date

Improvement Permit by: R A Tolle Date 10-8-12

Authorization to Construct by: R A Tolle Date 10-8-12

YOU SHOULD CONTACT A LOCATOR SERVICE PRIOR TO ANY EXCAVATION.

Installed by: WASTEWATER SOLUTIONS

Operation Permit by: R A Tolle Date: 7-31-15

Existing System Inspected by: Date:

WHITE COPY Environmental Health YELLOW COPY (Final) Owner / Applicant PINK COPY (Initial) Owner / Applicant