IREDELL COUNTY HEALTH DEPARTMENT

Statesville Office (704) 878-5305 Mooresville Office (704) 660-3625 PERMIT # 21960Z

IMPROVEMENT PERMIT / AUTHORIZATION TO CONSTRUCT / OPERATION PERMIT / EXISTING SYSTEM

PIN # 4649-49-4248

APPLICANT: AMERICAS HOME PLACE APPLICANT ADDRESS: 1206 GREENLAND DR. STATESVILLE

SITE ADDRESS: 277 CARLYLE RD., TROUTMAN PHONE: 704-746-7094 ALT. PHONE:

SITE DIRECTIONS: 21N, TL FLOWERHOUSE, TL CARLYLE, ON L

SUBDIVISION: SECTION: LOT # — LOT AREA: 1AC DESIGN FLOW: 480 L.T.A.R.: .3

Septic Tank	1000	(gal)	STB	760	Date	7-2-16	☒ New System ☐ Repair ☐ Expansion	System Type: I II (III) IV V VI	
Pump Tank		(gal)	PT		Date		System Description:	25% REDUCTION	
Pump Make			Model		Serial #		Repair System Description:	SAME	
# Nitrification Fields	1		# Lines	9	Linear Ft:	400'	Maintenance Agreement Required:	☐ YES ☒ NO	
Trench Width	36"		Max. Trench Bottom Depth	36"	Gravel Depth	—	☒ GRAVITY ☐ PRESSURE		

☒ Residence ☐ Business ☐ Other ☐ Slab ☒ Crawl Space ☐ Basement w/plumbing ☐ Basement w/o plumbing


No. Bedrooms 4 No. Persons 8 No. Employees —

Water Supply: ☒ Private ☐ Public ☐ Community


Comments / Conditions:

Installed Quick 4
* House not present at time of inspection.

INITIAL SITE SKETCH

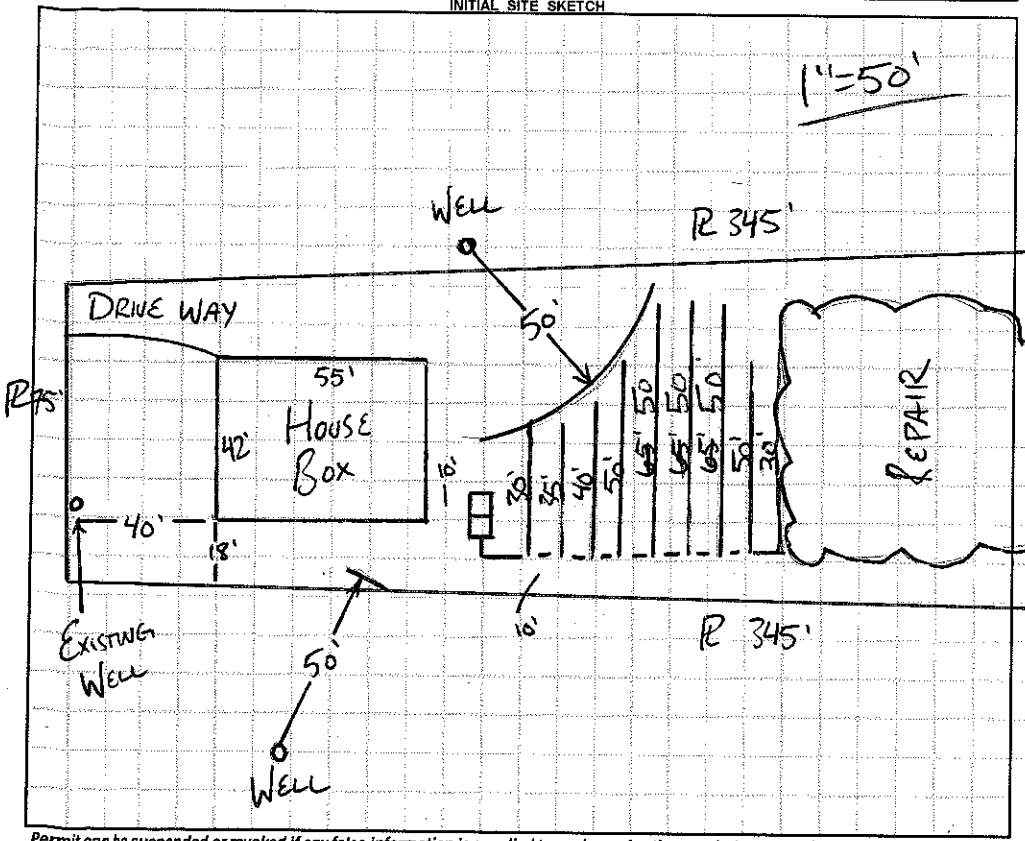

AS BUILT SKETCH

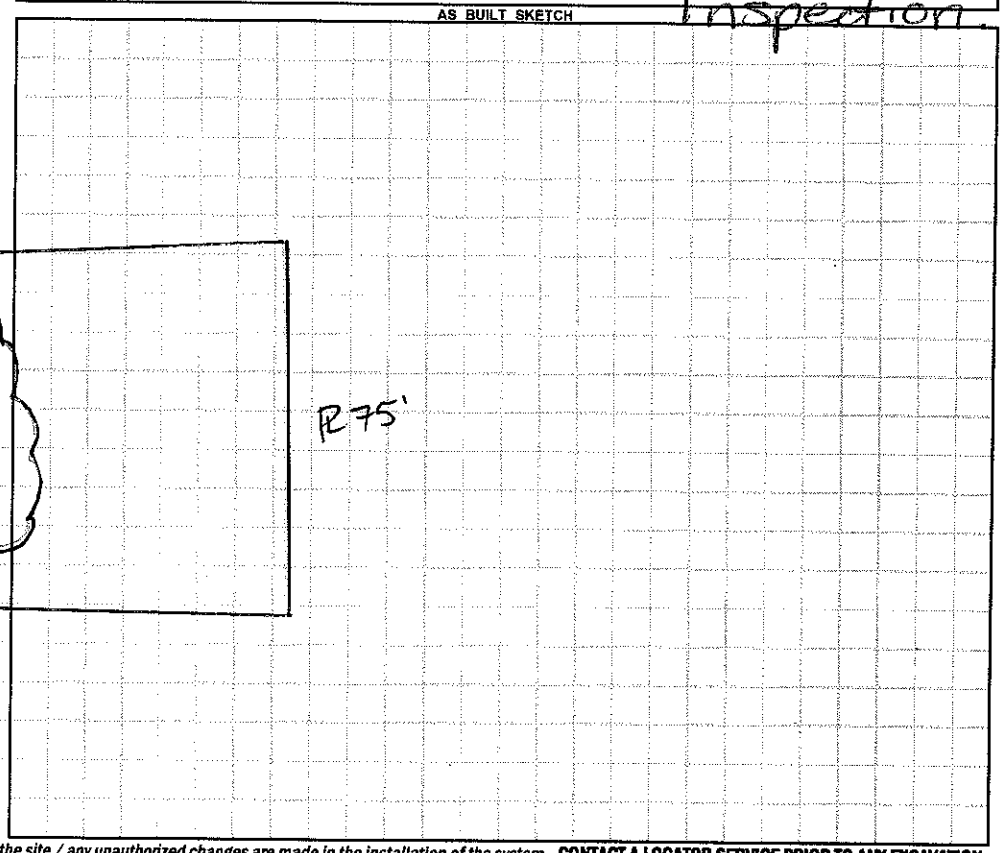

Permit can be suspended or revoked if any false information is supplied toward securing the permit / any unauthorized changes are made to the site / any unauthorized changes are made in the installation of the system. **CONTACT A LOCATOR SERVICE PRIOR TO ANY EXCAVATION**

☐ **IMPROVEMENT PERMIT** *with plat* valid without expiration. ☒ **IMPROVEMENT PERMIT** *with site plan* valid for 60 mos. ☒ **AUTHORIZATION TO CONSTRUCT** valid for period equal to IMPROVEMENT PERMIT--not to exceed 60 mo.

Owner / Applicant Signature: Debbie Date: 9/2/16 Installed by: Groundbreakers

IMPROVEMENT PERMIT by: RA Date: 8-29-16 OPERATION PERMIT by: Marian Dotson RS Date: 9/12/16

AUTHORIZATION TO CONSTRUCT by: RA Date: 8-29-16 Existing System Inspected by: Date:

Health Dept. Copy - WHITE Applicant (Final Approval) - YELLOW Applicant (Conditional Approval) - PINK