ICHD - ENVIRONMENTAL HEALTH DIVISION

Statesville Office (704) 878-5305 Mooresville Office (704) 660-3625

PERMIT # OSWP-2022-7393

SEPTIC: IMPROVEMENT PERMIT / AUTHORIZATION TO CONSTRUCT / OPERATION PERMIT / EXISTING SYSTEM

PIN # 4649-49-5350

APPLICANT / OWNER: Lentz Wastewater Management, Inc | APPLICANT ADDRESS: 463 Lentz Road, Statesville, NC 28625

SITE ADDRESS: 273 CARLYLE RD, TROUTMAN, NC 28166 | PHONE: (980) 829-3278 | ALT. PHONE:


SITE DIRECTIONS: N NC21 -> L Flower House -> L Carlyle -> lot on L | SAP CONTROLLED: YES EXIST NO

SUBDIVISION: N/A | SECTION: N/A | LOT #: N/A | LOT AREA: 1.03 | DESIGN FLOW: EXIST | L.T.A.R.: EXISTING


Septic Tank: 1000 (gal)	STB: 760	Date: 4-17-23	☐ New System ☒ Repair ☐ Expansion	System Type: II	☐ Residence	No. Bedrooms: EX.	Water Supply: Existing Well
Pump Tank: (gal)	PT:	Date:	System Description: Exsiting		☐ Business	No. Persons: 3	
Pump Make:	Model:	Serial #:	Repair System Description: New Tank		☐ Other	No. Employees:	
# Nitrification Fields: 1	# Lines: EXIST	Linear Ft.: EXIST	Maintenance Agreement Required: ☐ YES ☑ NO		☐ Slab	☑ Crawl Space	
Trench Width: EXIST	Trench Bottom Depth (Low side): EXIST		Gravel Depth: EXIST	☑ GRAVITY ☐ PRESSURE	☐ Basement w/ Plumbing	☐ Basement w/o Plumbing	

Comments / Conditions: Maintain 50' from existing well. Pump, crush, & fill existing tank. May use existing tank location if necessary, replace distribution device if needed.

INITIAL SITE SKETCH

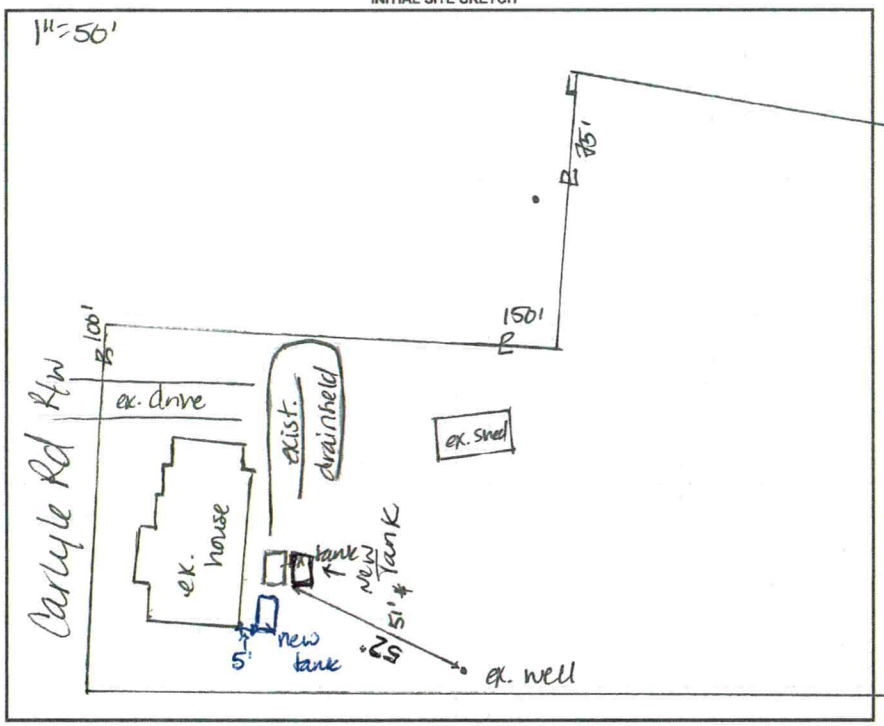

AS BUILT SKETCH

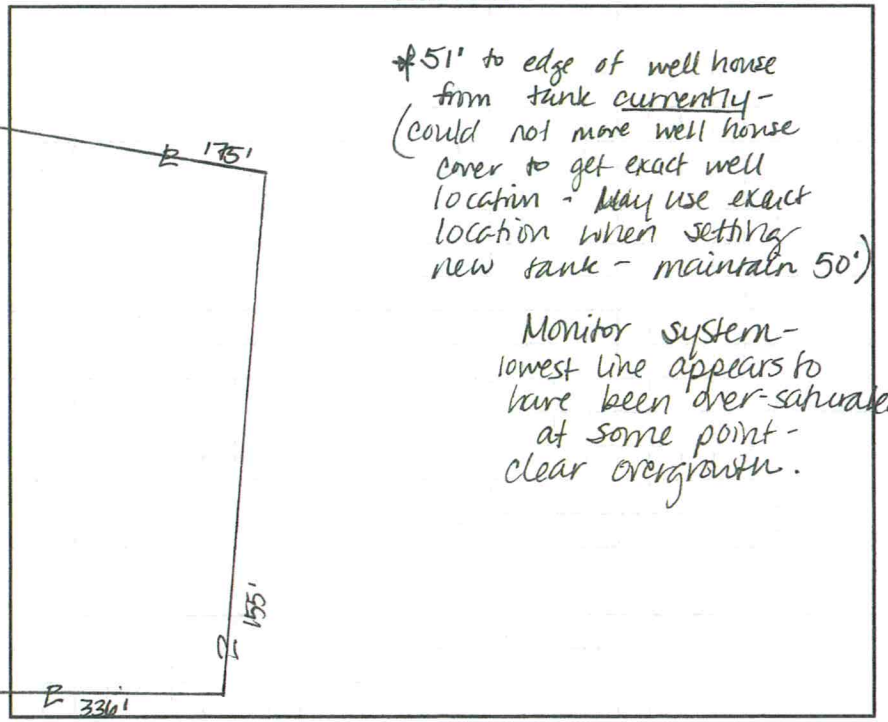

Permit can be suspended or revoked if any false information is supplied toward securing the permit / any unauthorized changes are made to the site / any unauthorized changes are made in the installation of the system. CONTACT A LOCATOR SERVICE PRIOR TO ANY EXCAVATION

☐ IMPROVEMENT PERMIT with plat valid without expiration. ☑ IMPROVEMENT PERMIT with site plan valid for 60 mos. ☑ AUTHORIZATION TO CONSTRUCT valid for period equal to IMPROVEMENT PERMIT--not to exceed 60 mo.

Owner / Applicant Signature: | Date: | Installed By: Lentz

IMPROVEMENT PERMIT by: D. Mebery | Date: 10/26/22 | OPERATION PERMIT by: Sydney Hollard | Date: 6/9/23

AUTHORIZATION TO CONSTRUCT by: D. Mebery | Date: 10/26/22 | Existing System Inspected By: | Date:

FOR SEPTIC FINAL INSPECTION CALL: 704-664-3703 BETWEEN 8am-9am the day the inspection is needed.

PERMIT SNAPSHOT REPORT OSWP-2022-7393 FOR IREDELL COUNTY

Permit Type: Environmental Health OSWP
Work Class: EH Septic Improvement Permit Repair
Status: PRIORITY PERMIT
Valuation: $0.00
Description: Septic Tank Collapsed

Project:
District: Iredell County
Square Feet: 0.00
Assigned To: Wieberg, Danielle

App Date: 10/19/2022
Exp Date: NOT AVAILABLE
Completed: NOT COMPLETED
Approval Expire Date:

Parcel: 4649495350.000 Main

Address: 273 Carlyle Rd Main
Troutman, NC 28166

Zone: RA(Residential Agricultural District)

Property Owner
Michael Hasslinger
Home: (704) 880-1557

Applicant/Authorized Agent
Jeanie Lentz
463 Lentz Road
Statesville, NC 28625

Applicant/Authorized Agent
Jeanie Lentz
Home: (980) 829-3278

Permit Custom Fields


How is your site plan being submitted	Custom Site Plan	Does the site contain any jurisdictional wetlands	No	Non-domestic Sewage Generated	No
Other Public Agency	No	Maximum Number of Bedrooms	3	Number of Occupants	3
Foundation Type	Crawl Space Foundation	Water Supply	Existing Well	Desired Septic System Type	No Preference
If other septic system type, please explain		Additional Unique Setbacks Apply	No		

Attachment File Name	Added On	Added By	Attachment Group	Notes
Signature_Jeanie_Lentz_10/19/2022.jpg	10/19/2022 13:50	Lentz, Jeanie		Uploaded via CSS
273_Carlyle_Road_-_Authorize_Legal_Representative-chris_forterei.com (1)_v1.pdf	10/20/2022 11:55	Nebel, Barbara	Available Online	Authorize to Act as Agent
273 Carlyle Rd-site plan.pdf	10/21/2022 15:19	Nebel, Barbara	Available Online	Site Plan

Invoice No.	Fee	Fee Amount	Amount Paid
NOT INVOICED	Existing System Septic Repair Permit	$150.00	$0.00
	Total for Invoice NOT INVOICED	**$150.00**	**$0.00**
	Grand Total for Permit	**$150.00**	**$0.00**

Workflow Step / Action Name	Action Type	Start Date	End Date
Application Completeness Check v.1		10/21/2022 0:00	10/21/2022 15:20
Confirm application complete v.1	Generic Action		10/21/2022 15:20
~~**Zoning Review v.1**~~			10/21/2022 15:20
~~Iredell County Zoning Approval v.1~~	Task		10/21/2022 15:20
~~Issue Invoice v.1~~	Generic Action		10/21/2022 15:20
~~Fees Paid v.1~~	Generic Action		10/21/2022 15:20
Assign v.1			
Case Assigned v.1	Generic Action		
Lot Readiness Verification v.1			
OSWP Septic Preliminary Site Visit v.1	Inspection		
OSWP Site Evaluation v.1	Inspection		
Permit Ready v.1			
Issue Permit v.1			
Issue Invoice v.1	Generic Action		
Fees Paid v.1	Generic Action		
Issue Permit v.1	Generic Action		
Environment Health Inspections v.1			

Carlyle Road

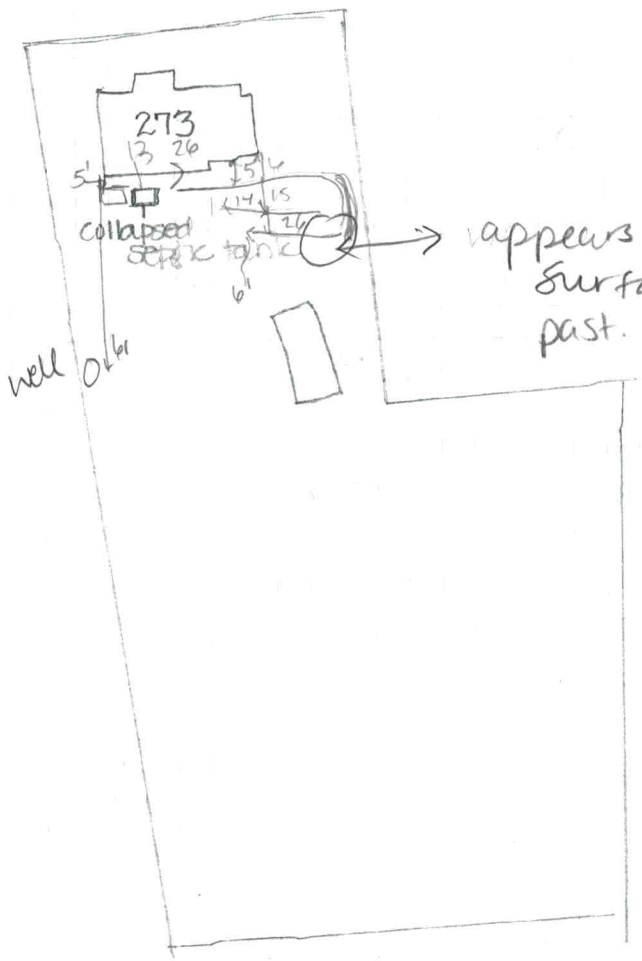

Recommend cleaning out the overgrowth, checking all plumbing for leaks & monitoring the area

Address: 273 Carlyle Rd Trattman
Current HO: Michael Hassinger **HO #:** _____
# of Bed: 3 **# of Occupants:** 3
Foundation Type: (Crawlspace) Slab B/WP B/WOP
Water supply: Public (Well) **Other:** _____
Year Installed: 1960