IREDELL COUNTY HEALTH DEPARTMENT

Authorization to Construct

STATESVILLE 704-878-5305 MOORESVILLE 704-664-5281

IMPROVEMENT PERMIT / ~~CERTIFICATE OF COMPLETION~~ / OPERATION PERMIT / EXISTING SYSTEM INSPECTION

PROPERTY DESCRIPTION NO. 25305 DATE 7/18/97 TAX MAP NO. 2F 3B 24 Watershed: [X] Yes [ ] No

OWNER OR CONTRACTOR Charles Childers PHONE: Business 4649 49 5856 Home 522-1940

ADDRESS 248 Carlyle Rd. Mooresville, NC.

LOCATION 115 N TL FH Loop TL Carlyle Rd. ~ .8 miles on (R), to end of drive

SUBDIVISION Carlyle Farms BLOCK / SECTION 2 LOT 24 LOT AREA > 4 AC SITE CLASS. PS DESIGN FLOW 360 L.T.A.R. .3

Septic Tank: 1000 Gallons; STB 55 Date 7/2/97

Pump Tank: 1000 Gallons; PT 32 Date

Pump Make: Model Serial No.

Nitrification Field: No Fields 1 Square Feet 1200 Linear Feet 400

No Lines 4 Trench Width 36" Max Trench Bottom Depth 30" Gravel Depth 12"

[X] New System [ ] Repair System Type: I, II, (III) IV, V, VI

System Description: PreMan — Conventional

Repair System Description: Same

Maintenance Agreement Required: [ ] Yes [X] No

[X] House/Mod. Home No. Bedrooms 3

[ ] Mobile Home No. Bathrooms 3

[ ] Business No. Employees

[ ] Other


[ ] Slab [X] Crawl Space [ ] Basement w/plumbing [ ] Basement wo/plumbing

Water Supply: [X] Individual [ ] Community [ ] Public


Comments:

Comments:

INITIAL SITE SKETCH

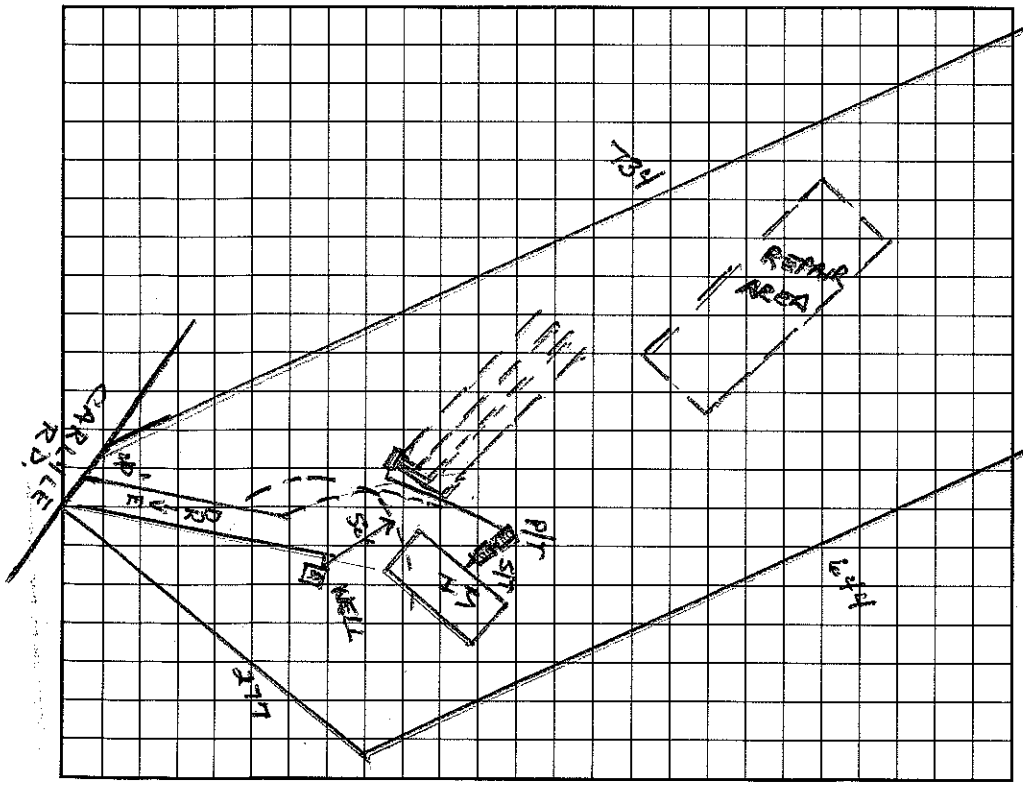

AS BUILT SKETCH

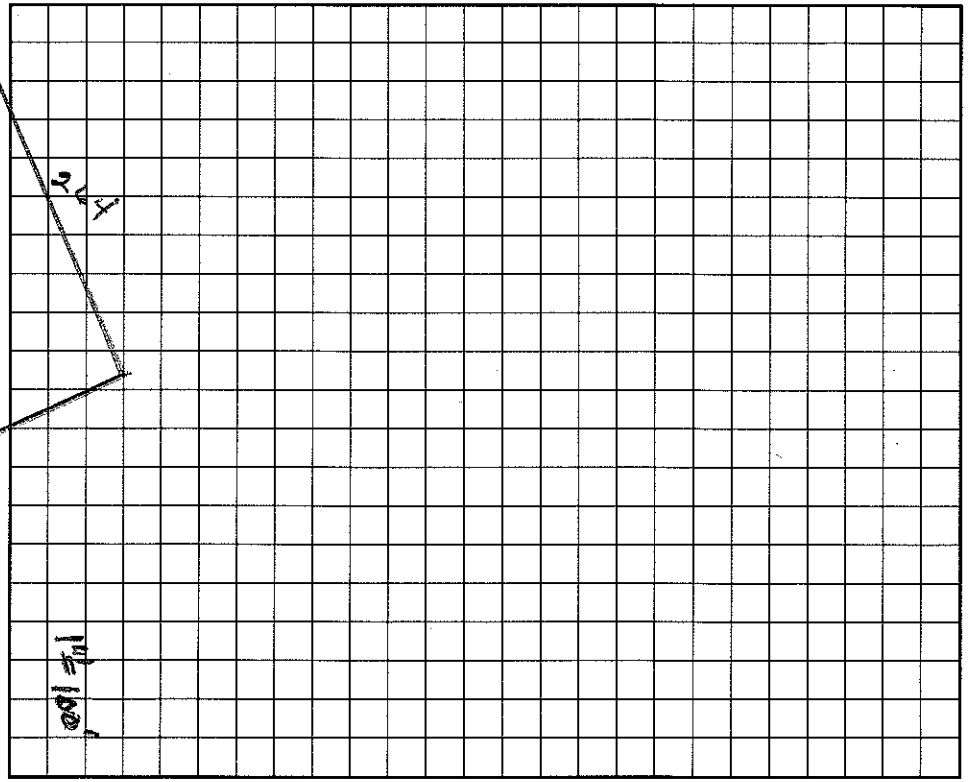

I understand that this permit can be suspended or revoked if any false information is supplied toward securing the permit/any unauthorized changes are made to the site/any unauthorized changes are made in the installation of the system. Improvement Permit is valid for 60 months from date of issuance.

Signed: X

Improvement Permit by: Wesley Sparks RS. date 7/18/95

Existing System Inspection by: Wesley Sparks RS. date 7/18/95

Installed by: Larry Rapp

Certificate of Completion by: Wesley Sparks RS date 9/29/97

Operation Permit by: Wesley Sparks RS. date 9/29/97

HEALTH DEPT. COPY: WHITE / INSPECTION COPY (FINAL): GREEN / OWNER COPY (FINAL): YELLOW / INSPECTION COPY (INITIAL): PINK / OWNER COPY (INITIAL): GOLD