IREDELL COUNTY HEALTH DEPARTMENT

STATESVILLE 704-878-5305 MOORESVILLE 704-664-5281

IMPROVEMENT PERMIT / AUTHORIZATION TO CONSTRUCT / OPERATION PERMIT / EXISTING SYSTEM INSPECTION

PERMIT# 073439 PIN# 4649499303 DATE 5/13/98

OWNER OR CONTRACTOR BESSIE M. BYERS PHONE: Business Home 528-6983

ADDRESS 261 BYERS RD. TROUTMAN NC 28166

LOCATION FLOWER HOUSE LOOP - TL CARLYLE RD - ON LT BESIDE ## 263 PAST 1ST MARIO LOOP

SUBDIVISION — BLOCK / SECTION — LOT — LOT AREA 3.03AC SITE CLASS. RS DESIGN FLOW 360 L.T.A.R. —

Septic Tank: EXISTING Gallons; STB Date

Pump Tank: Gallons; PT Date

Pump Make: Model Serial No.

Nitrification Field: No Fields 1 Square Feet 300 Linear Feet 100

No Lines 2@50' Trench Width 36" Max Trench Bottom Depth 36" Gravel Depth 12"

☑ New System ☐ Repair System Type: I, II, III, IV, V, VI

System Description: GRAVITY CONVENSIONAL

Repair System Description: SAME

Maintenance Agreement Required: ☐ Yes ☑ No

☐ House/Mod. Home No. Bedrooms 3

☑ Mobile Home No. Bathrooms 2

☐ Business No. Employees

☐ Other

☐ Slab ☑ Crawl Space ☐ Basement w/plumbing ☐ Basement wo/plumbing

Water Supply: ☑ Individual ☐ Public ☐ Community


Comments:/Conditions:

Comments:/Conditions:


MH Home not on lot. FROM NEIGHBOR

NOT TO SCALE

INITIAL SITE SKETCH

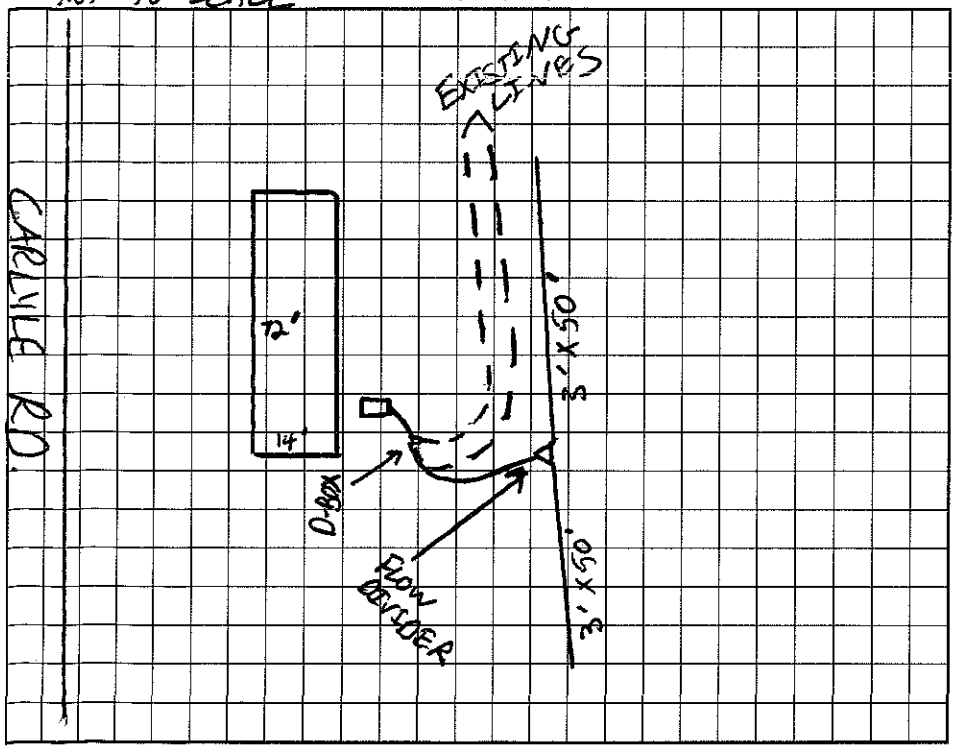

AS BUILT SKETCH

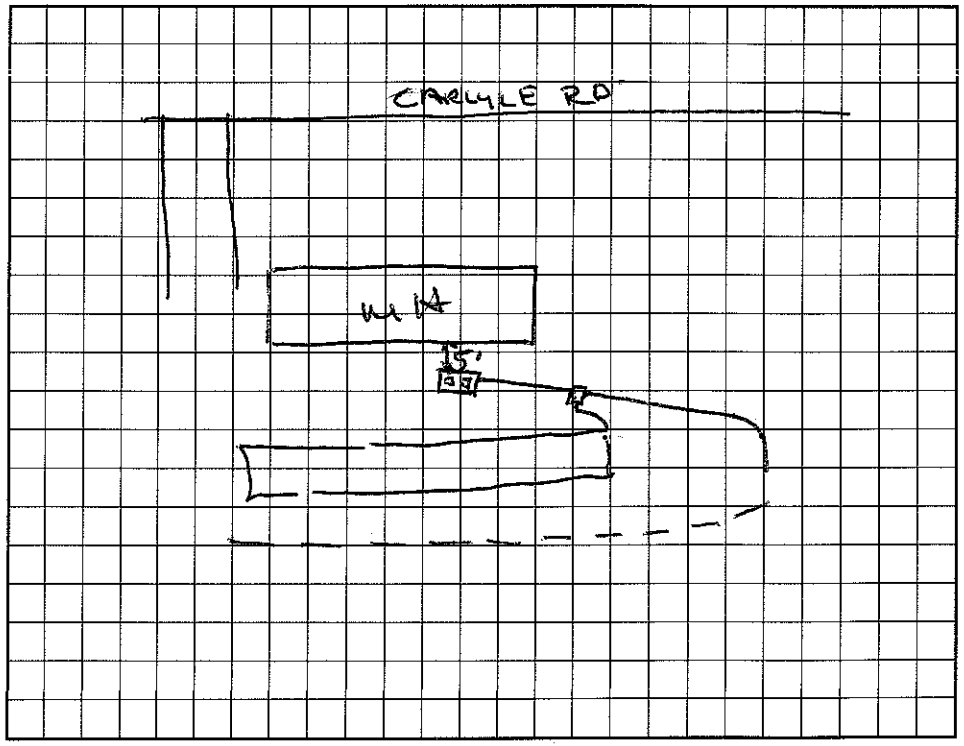

I understand that this permit can be suspended or revoked if any false information is supplied toward securing the permit/any unauthorized changes are made to the site/any unauthorized changes are made in the installation of the system. Improvement Permit with plat valid without expiration. Improvement Permit with site plan valid for sixty months. Authorization to Construct is valid for a period equal to that of Improvement Permit – not to exceed sixty months.

Signed: Edward Brown date 5-18-98 Installed by: Kenny Madison

Improvement Permit by: RS date 5/13/98 Operation Permit by: Wesley Sparks date 6/2/98

Authorization to Construct by: RS date 5/13/98 Existing System Inspection by: Wesley Sparks date 6/2/98

HEALTH DEPT. COPY: WHITE INSPECTION COPY (FINAL): GREEN OWNER COPY (FINAL): YELLOW INSPECTION COPY (INITIAL): PINK OWNER COPY (INITIAL): GOLD