IREDELL COUNTY HEALTH DEPARTMENT

STATESVILLE 704-878-5305 MOORESVILLE 704-664-5281

4649594701

IMPROVEMENT PERMIT / CERTIFICATE OF COMPLETION / OPERATION PERMIT / EXISTING SYSTEM INSPECTION

PROPERTY DESCRIPTION NO. 23872 DATE 8/20/96 TAX MAP NO. 4FA89

OWNER OR CONTRACTOR Charles F ~~Hoston~~ HOSTON PHONE: Business _____ Home _____ Watershed: ☒ Yes ☐ No

ADDRESS 229 Carlyle Rd. Troutman, NC. 28166

LOCATION Flower Hobe Loop, TL on Carlyle Rd. beside #229 just past Marlo Loop

SUBDIVISION — BLOCK / SECTION _____ LOT _____ LOT AREA _____ SITE CLASS. _____ DESIGN FLOW _____ L.T.A.R. _____

Septic Tank: 1000 Gallons; STB 794 Date 10/29/97

Pump Tank: _____ Gallons; PT _____ Date _____

Pump Make: _____ Model _____ Serial No. _____

Nitrification Field: No Fields 1 Square Feet 1200 Linear Feet 400

No Lines 4 Trench Width 36" Max Trench Bottom Depth 36" Gravel Depth 12"

☒ New System ☐ Repair System Type: I (II) III. IV. V. VI

System Description: CONV - DIST BOX

Repair System Description: SAME

Maintenance Agreement Required: ☐ Yes ☒ No

☐ House/Mod. Home ☒ Mobile Home ☐ Business ☐ Other

No. Bedrooms 3 No. Bathrooms 2 No. Employees ____


☐ Slab ☒ Crawl Space ☐ Basement w/plumbing ☐ Basement wo/plumbing

Water Supply: ☒ Individual ☐ Community ☐ Public SISTERS


Comments:

Comments: Wells

INITIAL SITE SKETCH

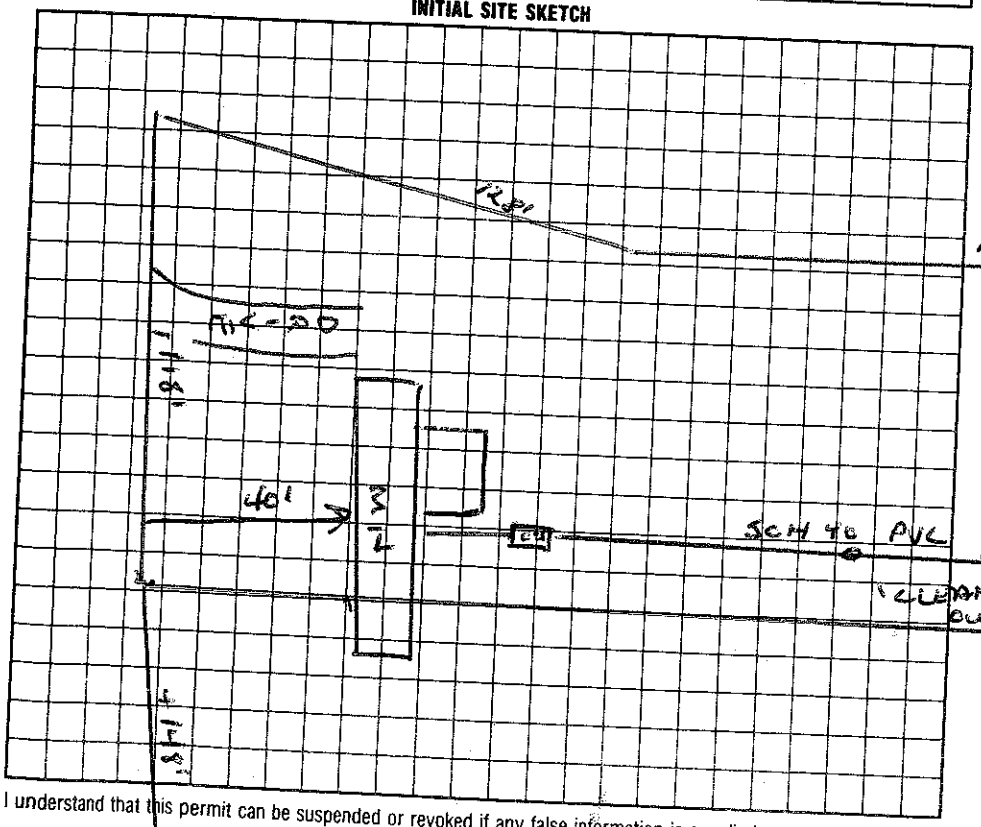

AS BUILT SKETCH

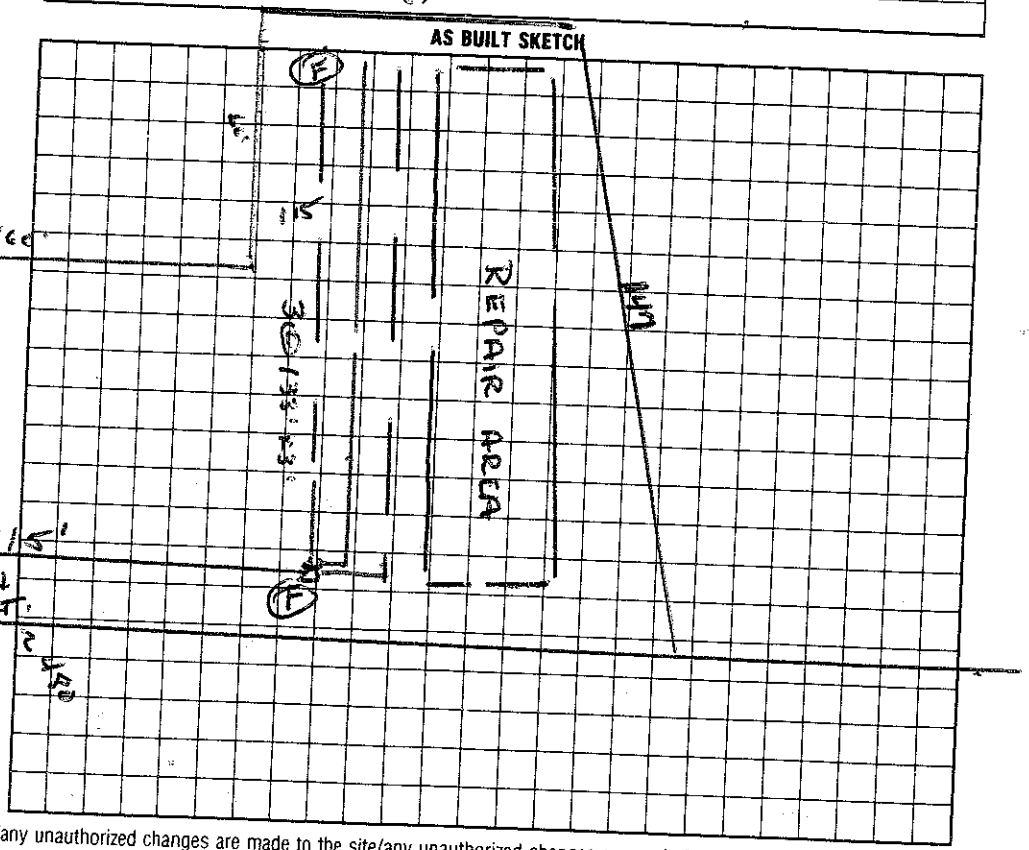

I understand that this permit can be suspended or revoked if any false information is supplied toward securing the permit/any unauthorized changes are made to the site/any unauthorized changes are made in the installation of the system.

Signed: ~~Charles F Hoston~~ Charles F Hoston

Improvement Permit by: Wesley Sparks R.S. date 8/20/96

Existing System Inspection by: Wesley Sparks R.S. date 8/20/96

Installed by: Ace General Contractors

Certificate of Completion by: Wesley Sparks R.S. date 11/12/97

Operation Permit by: Wesley Sparks R.S. date 11/12/97

HEALTH DEPT. COPY: WHITE INSPECTION COPY (FINAL): GREEN OWNER COPY (FINAL): YELLOW INSPECTION COPY (INITIAL): PINK OWNER COPY (INITIAL): GOLD