4649645121

# IREDELL COUNTY HEALTH DEPARTMENT

STATESVILLE 704-878-5305 MOORESVILLE 704-664-5281

## IMPROVEMENT PERMIT / CERTIFICATE OF COMPLETION / OPERATION PERMIT / EXISTING SYSTEM INSPECTION

PROPERTY DESCRIPTION NO. 16639 DATE 7/16/93 TAX MAP NO. 2R-A-27

OWNER OR CONTRACTOR TIMOTHY R. TAYLOR PHONE: Business Home 392-3609

ADDRESS 8828 LARKHAVEN RD. CHAR, NC.

LOCATION RANKIN HILL RD, ON R JUST BEFORE CROSSING I-77

SUBDIVISION BLOCK / SECTION LOT LOT AREA ~3.7AC SITE CLASS. P L.T.A.R. .25-.3

Water Supply: ☑ Individual ☐ Community ☐ Public

Septic Tank: 1000 Gallons; STB 359 Date 12/3/93

Pump Tank: Gallons; PT Date

Nitrification Field: No. Fields 1 Square Feet 1200 Linear Feet 400

No. Lines 4 Trench Width 3' Trench Depth 36" Gravel Depth 12"

☑ New System ☐ Repair System Type: I, (II), III, IV, V, VI

System Description: CONV

Repair System Description: CONV.

Maintenance Agreement Required: ☐ Yes ☑ No

☑ House/Mod. Home No. Bedrooms 3 Garbage Disposal: ☐ Yes ☑ No

☐ Mobile Home No. Bathrooms 2 Auto. Dishwasher: ☑ Yes ☐ No


☐ Business No. Employees Auto. Washing Machine: ☑ Yes ☐ No

☐ Other Other

☐ Slab ☐ Crawl Space ☐ Basement w/plumbing ☑ Basement wo/plumbing

Comments TRENCH DEPTH 36" MAXIMUM - ON CONTOUR IN DIRECTION SHOWN.

**INITIAL SITE SKETCH**

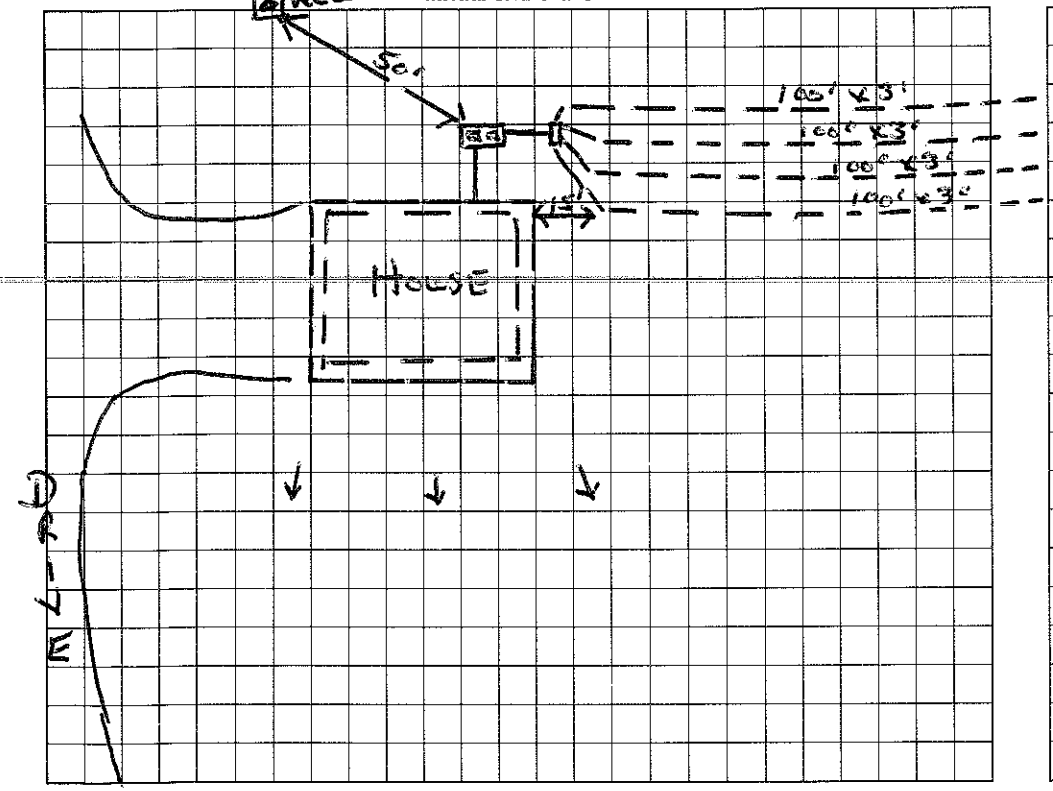


**AS BUILT SKETCH**

Installed as drawn.

I understand that this permit can be suspended or revoked if any false information is supplied toward securing the permit/any unauthorized changes are made to the site/any unauthorized changes are made in the installation of the system. Improvement Permit is valid for 60 months from date of issuance.

Signed: R Taylor

Improvement Permit by: Wesley Sparks R.S. date 7/16/93

Existing System Inspection by: date

Installed by: Ordison Const. Co.

Certificate of Completion by: Wesley Sparks R.S. date 3/16/94

Operation Permit by: date

HEALTH DEPT. COPY: WHITE INSPECTION COPY (FINAL): GREEN OWNER COPY (FINAL): YELLOW INSPECTION COPY (INITIAL): PINK OWNER COPY (INITIAL): GOLD