IREDELL COUNTY HEALTH DEPARTMENT

Statesville Office (704) 878-5305 Mooresville Office (704) 660-3625 PERMIT # 211363

IMPROVEMENT PERMIT / AUTHORIZATION TO CONSTRUCT / OPERATION PERMIT / EXISTING SYSTEM

PIN # 4649-64-6517.000

APPLICANT: Mark Cline APPLICANT ADDRESS: 392 Rankin Hill Rd. Troutman NC

SITE ADDRESS: 392 Rankin Hill Rd. Troutman NC 28166 PHONE: 704-402-0060 ALT. PHONE:

SITE DIRECTIONS: Hwy 21 Toward Mooresville, TL Flowerhouse Ln., TL Rankin Hill, Site on R

SUBDIVISION: — SECTION: — LOT # — LOT AREA: 6.47 Acre DESIGN FLOW: Ex. 360 GPD L.T.A.R.: Existing

Septic Tank Existing (gal) STB Date

Pump Tank (gal) PT Date

Pump Make Model Serial #

Nitrification Fields Ex. # Lines Ex. 4 Linear Ft: Existing

Trench Width Ex. Max. Trench Bottom Depth Ex. Gravel Depth Ex.

☐ New System ☐ Repair ☐ Expansion System Type: I (II) III IV V VI

System Description: Existing Conventional

Repair System Description: Conventional

Maintenance Agreement Required: ☐ YES ☒ NO

☒ GRAVITY ☐ PRESSURE

☒ Residence No. Bedrooms Ex. 3

☐ Business No. Persons Ex. 6

☐ Other No. Employees


☐ Slab ☒ Crawl Space

☐ Basement w/plumbing ☐ Basement w/o plumbing


Water Supply: ☒ Private ☐ Public ☐ Community

Comments / Conditions: System Appeared To Be Functioning @ Time of Inspection.
New Home To Be Set In Same Location As Existing Home.

INITIAL SITE SKETCH

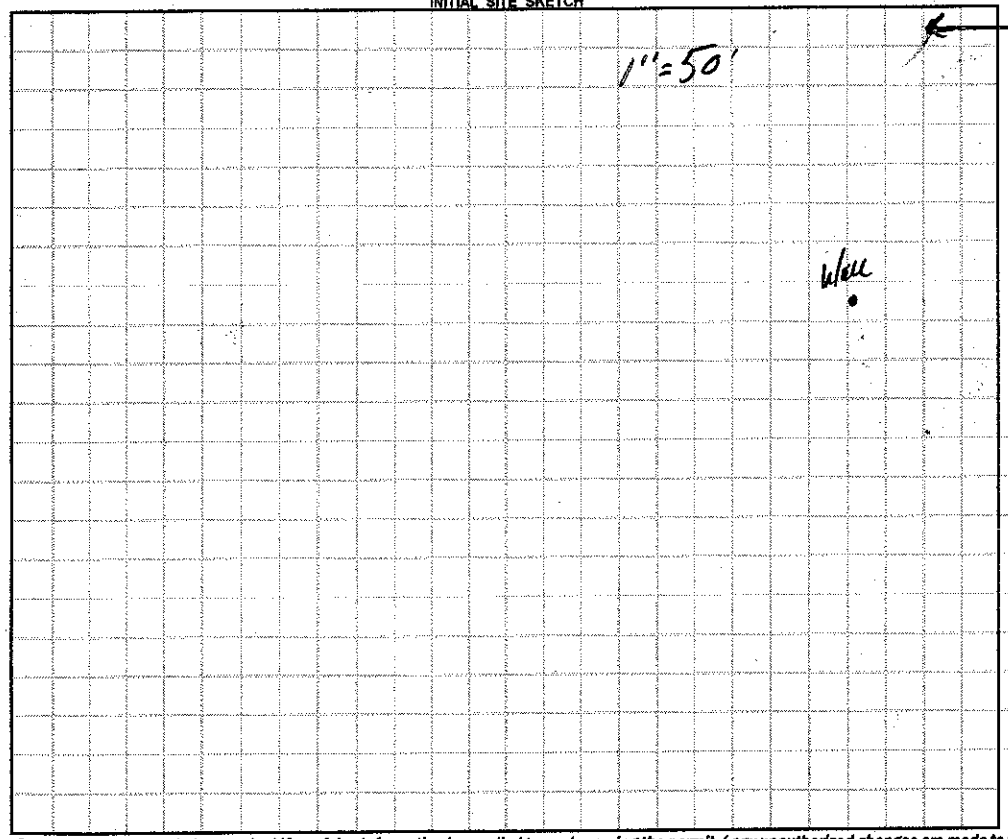

AS BUILT SKETCH

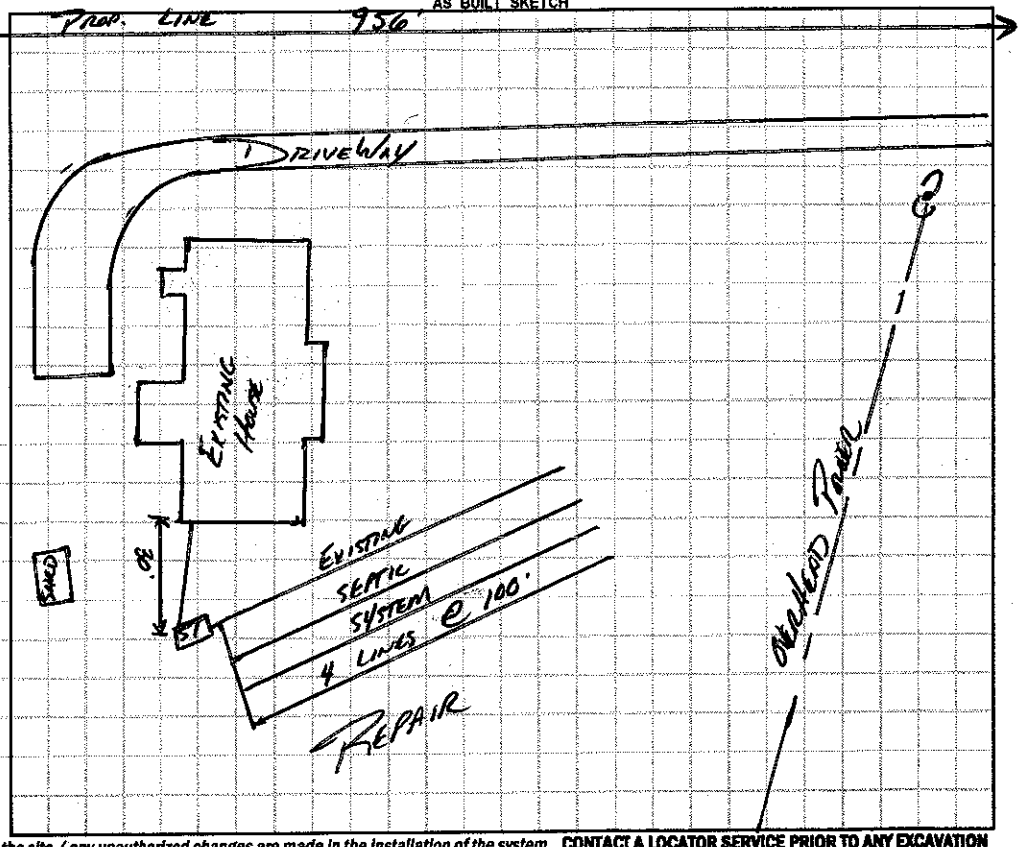

Permit can be suspended or revoked if any false information is supplied toward securing the permit / any unauthorized changes are made to the site / any unauthorized changes are made in the installation of the system. **CONTACT A LOCATOR SERVICE PRIOR TO ANY EXCAVATION**

☐ **IMPROVEMENT PERMIT** *with plat valid without expiration.* ☐ **IMPROVEMENT PERMIT** *with site plan valid for 60 mos.* ☐ **AUTHORIZATION TO CONSTRUCT** *valid for period equal to IMPROVEMENT PERMIT--not to exceed 60 mo.*

Owner / Applicant Signature: Mark Cline Date: 7-8-15 Installed by:

IMPROVEMENT PERMIT by: Date: OPERATION PERMIT by: Date:

AUTHORIZATION TO CONSTRUCT by: Date: Existing System Inspected by: APPROVED Date: JUN 26 2015

Health Dept. Copy - WHITE Applicant (Final Approval) - YELLOW Applicant (Conditional Approval) - PINK

1:600 1:600

