IREDELL COUNTY HEALTH DEPARTMENT

STATESVILLE 704-878-5305 MOORESVILLE 704-664-5281

IMPROVEMENT PERMIT / AUTHORIZATION TO CONSTRUCT / OPERATION PERMIT / EXISTING SYSTEM INSPECTION

PERMIT# 80829 PIN# 4649667891 PT 4649653930 DATE 7/6/99

OWNER OR CONTRACTOR PIEDMONT HOUSING PHONE: Business _____ Home 528-7120

ADDRESS 1070 CHARLOTTE HWY TROUTMAN NC 28166

LOCATION 21/115N - TL FLOWER HOUSE - TL RANKEN HILL TR GAYLE - TL WINDSTAR AT END

SUBDIVISION WESTWINDS BLOCK / SECTION > LOT 32 LOT AREA .84 AC SITE CLASS. PS DESIGN FLOW 360 GPD L.T.A.R. .3 GPD/FT²

Septic Tank: 1000 Gallons; STB 1017 Date 9/4/98
Pump Tank: _____ Gallons; PT _____ Date _____
Pump Make: _____ Model _____ Serial No. _____
Nitrification Field: No Fields 1 Square Feet 900 Linear Feet 300
No Lines 3@100' Trench Width 36" Max Trench Bottom Depth 36" Gravel Depth N/A

☑ New System ☐ Repair System Type: I, II, III, IV, V, VI
System Description: GRAVITY CHAMBERS OR HDS
Repair System Description: PANEL
Maintenance Agreement Required: ☐ Yes ☑ No


☐ House/Mod. Home No. Bedrooms 3
☑ Mobile Home No. Bathrooms 2
☐ Business No. Employees _____
☐ Other _____
☐ Slab ☑ Crawl Space ☐ Basement w/plumbing ☐ Basement wo/plumbing

Water Supply:
☑ Individual
☐ Public
☐ Community


Comments:/Conditions:

Comments:/Conditions:

1"=50' INITIAL SITE SKETCH

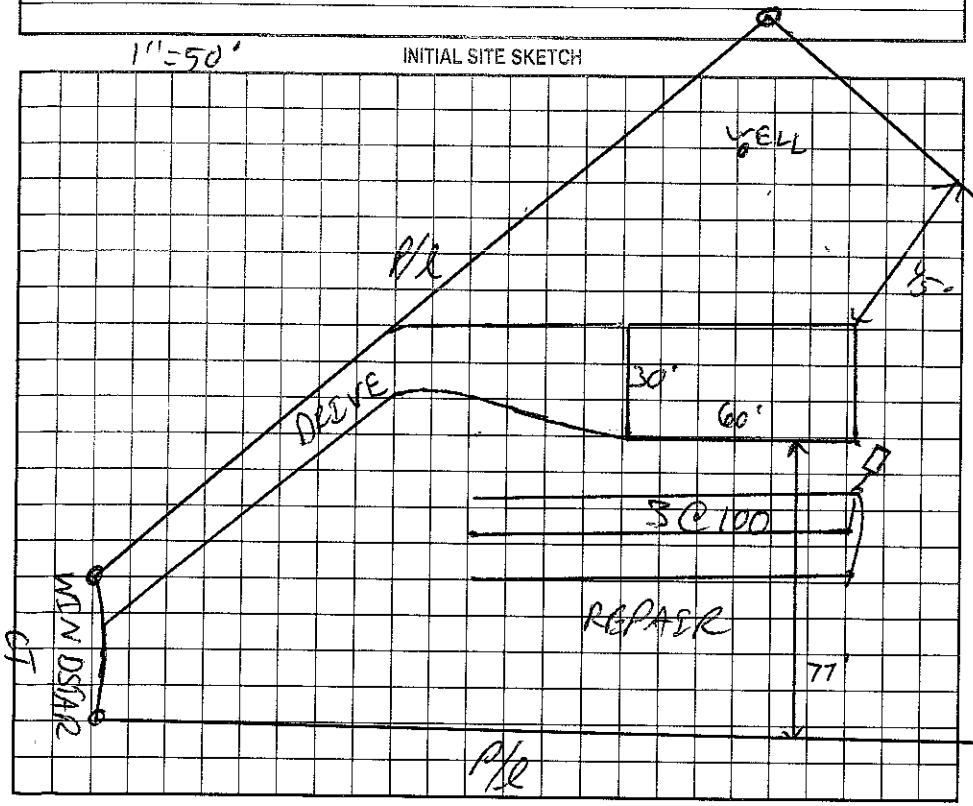

AS BUILT SKETCH

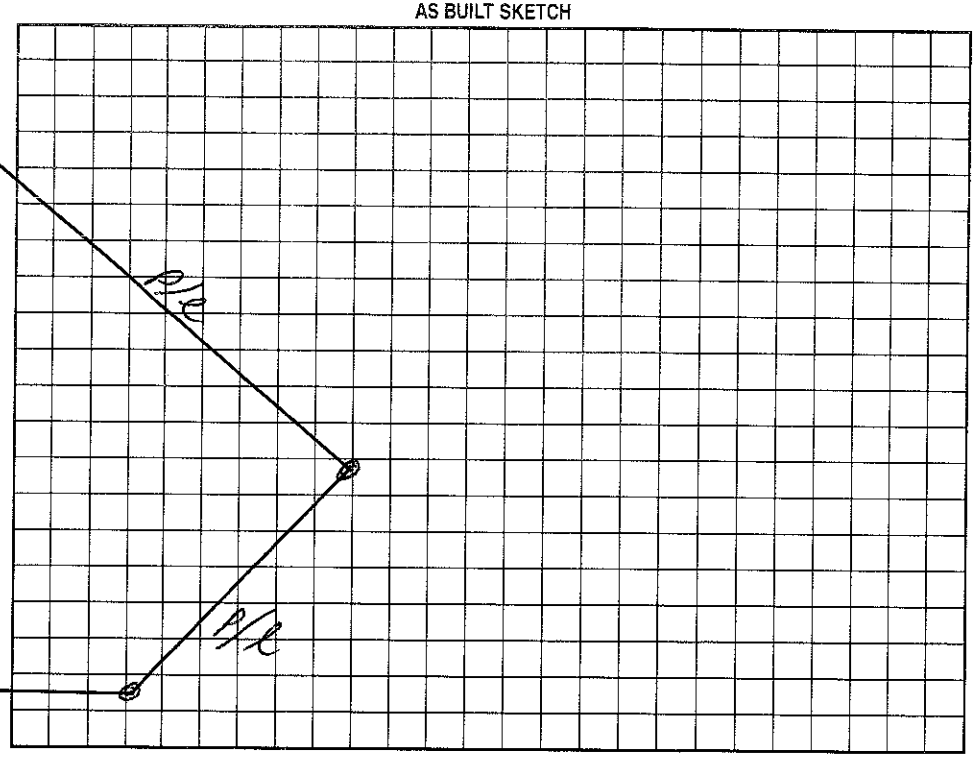

Permit can be suspended or revoked if any false information is supplied toward securing the permit/any unauthorized changes are made to the site/any unauthorized changes are made in the installation of the system. Improvement Permit with plat valid without expiration. Improvement Permit with site plan valid for sixty months. Authorization to Construct is valid for a period equal to that of Improvement Permit – not to exceed sixty months.

Signed: Iredell County date 7/8/99 Installed by: A-1 Backhoe

Improvement Permit by: _____ RS date 7/8/99 Operation Permit by: Wesley Sparks RS date 12/7/99

Authorization to Construct by: _____ RS date 7/8/99 Existing System Inspection by: _____ date _____

HEALTH DEPT. COPY: WHITE OWNER COPY (FINAL): YELLOW OWNER COPY (INITIAL): PINK