IREDELL COUNTY HEALTH DEPARTMENT

STATESVILLE 704-878-5305 MOORESVILLE 704-664-5281

IMPROVEMENT PERMIT / AUTHORIZATION TO CONSTRUCT / OPERATION PERMIT / EXISTING SYSTEM INSPECTION

PERMIT# 105395 PIN# ~~4649-75-0566.10~~ 4649-65-4023 DATE August 8, 02

OWNER OR CONTRACTOR Perimeter Properties // Patricia Colleen Hamko PHONE: Business (704) 932-9100 Home

ADDRESS 1709 S. Main St Kannapolis, N.C. 28081 // 714 Lamtree Rd, Mooresville, N.C. 28117

LOCATION I-77 N TL Flower House Loop TL Rankin Hill Rd TR Ty-Lin Way on left

SUBDIVISION Magic Forest BLOCK / SECTION 3 LOT 10 LOT AREA .71 Ac SITE CLASS PS DESIGN FLOW 360gpd L.T.A.R. .03

Septic Tank: 1000 Gallons; STB 1012 Date 5/3/02

Pump Tank: Gallons; PT Date

Pump Make: Model Serial No.

Nitrification Field: No Fields 1 Square Feet 1200 Linear Feet 400

No Lines 3 Center feed Trench Width 36" Max Trench Bottom Depth 36" Gravel Depth 12"

☑ New System ☐ Repair System Type: I, II, III, IV, V, VI

System Description: Gravity Conventional

Repair System Description: Gravity 25% Reduction

Maintenance Agreement Required: ☐ Yes ☑ No

☐ House/Mod. Home No. Bedrooms 3

☑ Mobile Home DW No. Bathrooms 2

☐ Business No. Employees

☐ Other


☐ Slab ☑ Crawl Space ☐ Basement w/plumbing ☐ Basement wo/plumbing

Water Supply: ☑ Individual ☐ Public ☐ Community

Comments:/Conditions:

Comments:/Conditions:

INITIAL SITE SKETCH

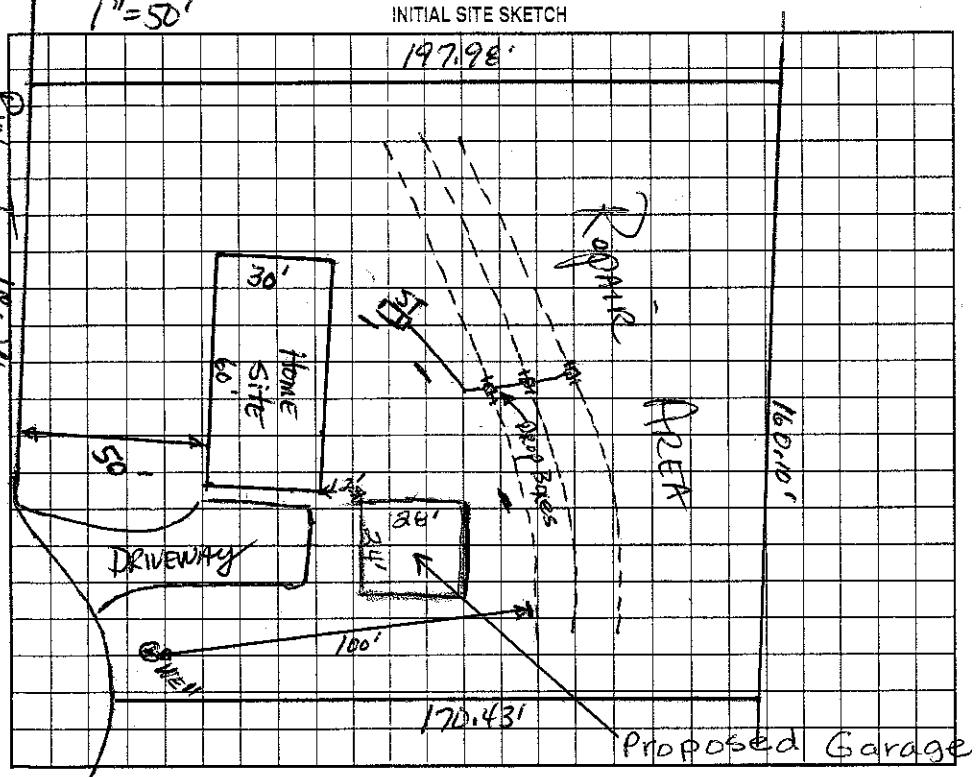

AS BUILT SKETCH

The proposed / existing Garage addition does not appear to impact the existing septic system.

**NOTE: Placed 12' behind house - shall be min. 5' from septic system, 25' from well.

Andy Melville R.S.

Date: 01-31-12

ICHD-Environmental Health Division

Permit can be suspended or revoked if any false information is supplied toward securing the permit/any unauthorized changes are made to the site/any unauthorized changes are made in the installation of the system. Improvement Permit with plat valid without expiration. Improvement Permit with site plan valid for sixty months. Authorization to Construct is valid for a period equal to that of Improvement Permit – not to exceed sixty months.

Signed: Tom Lew date 8-9-02 Installed by: A-1 Back hoe

Improvement Permit by: Mark R. Hinson IRS date 8-8-02 Operation Permit by: RS date 8/16/02

Authorization to Construct by: Mark R. Hinson IRS date 8-9-02 Existing System Inspection by: date

HEALTH DEPT. COPY: WHITE OWNER COPY (FINAL): YELLOW OWNER COPY (INITIAL): PINK