IREDELL COUNTY HEAL... ..EPARTMENT

STATESVILLE 704-878-[illegible]05 02 MOORESVILLE 704-664-5281 10:00

IMPROVEMENT PERMIT / AUTHORIZATION TO CONSTRUCT / OPERATION PERMIT / EXISTING SYSTEM INSPECTION

PERMIT# 104128 11878 PIN# 4649750566 4649654485 Terry Smith DATE 5-10-03

OWNER OR CONTRACTOR Schutt Housing PHONE: Business 902-1836 Home

ADDRESS Hwy 115 / 21 North TL Flower House Loop TL Rankin Hill TR Laramie Ct at end on left

LOCATION LARAMIE CT. AT END ON L OFF CUL DE SAC

SUBDIVISION Magic Forest BLOCK / SECTION 3 LOT A LOT AREA .85 Acre SITE CLASS. PS DESIGN FLOW 480gpd L.T.A.R. .3

Septic Tank: 1000 Gallons; STB 1042 Date 12/23/03
Pump Tank: 1000 Gallons; PT 97 Date 12/4/03
Pump Make: Goulds Model WE03311M Serial No. [illegible]
Nitrification Field: No Fields 1 Square Feet 1200 Linear Feet 400'
No Lines 3@134' Trench Width 36" Max Trench Bottom Depth 36" Gravel Depth N/A

☒ New System ☐ Repair System Type: I, II, III, IV, V, VI
System Description: Pump (PM) 25% Reduct.
Repair System Description: Pump Panel Blk
Maintenance Agreement Required: ☐ Yes ☒ No


☒ House/Mod. Home No. Bedrooms 4
☐ Mobile Home No. Bathrooms 2
☐ Business No. Employees
☐ Other
☐ Slab ☒ Crawl Space ☐ Basement w/plumbing ☐ Basement wo/plumbing

Water Supply: ☒ Individual ☐ Public ☐ Community

Comments:/Conditions: Scale 1:50

PL 203.5

INITIAL SITE SKETCH

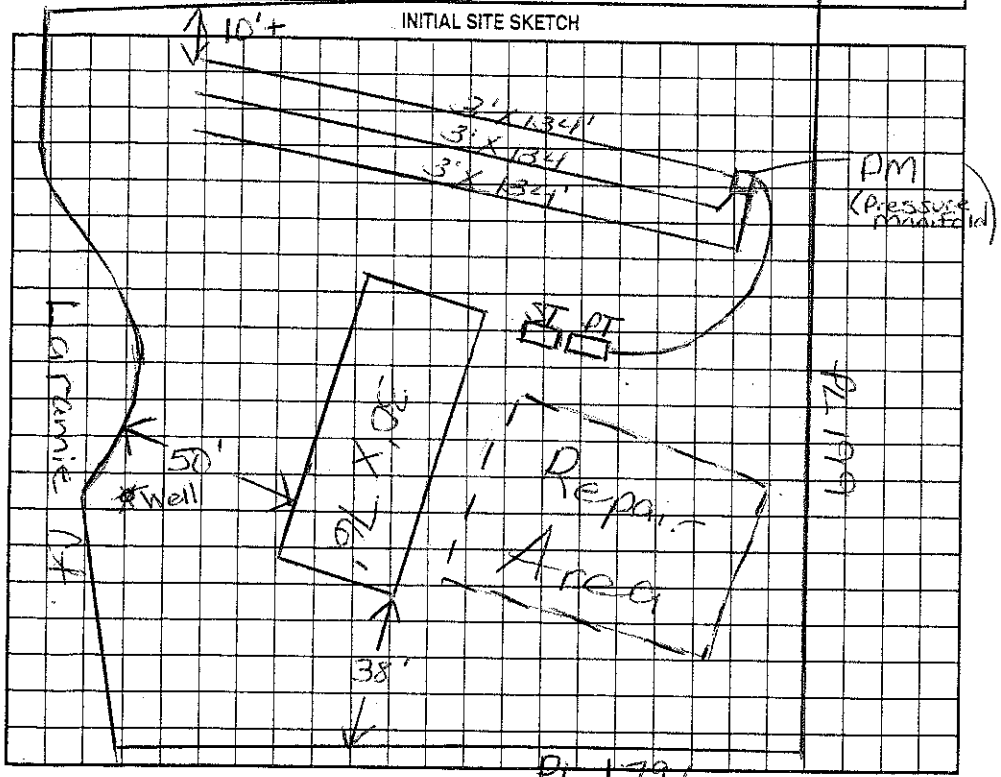

Comments:/Conditions:

AS BUILT SKETCH

Infiltrators
Installed
As Drawn

Permit can be suspended or revoked if any false information is supplied toward securing the permit/any unauthorized changes are made to the site/any unauthorized changes are made in the installation of the system. Improvement Permit with plat valid without expiration. Improvement Permit with site plan valid for sixty months. Authorization to Construct is valid for a period equal to that of Improvement Permit – not to exceed sixty months.

Signed: Sarah Lindy date 5/11/04

Improvement Permit by: Maria H. Brown RS date 5/10/04

Authorization to Construct by: Maria H. Brown RS date 5/10/04

Installed by: A-1 Backhoe

Operation Permit by: Wesley Sparks RS date 6/25/04

Existing System Inspection by: date

HEALTH DEPT. COPY: WHITE OWNER COPY (FINAL): YELLOW OWNER COPY (INITIAL): PINK

