IREDELL COUNTY HEALTH DEPARTMENT

STATESVILLE 704-878-5305 MOORESVILLE 704-664-5281

IMPROVEMENT PERMIT / AUTHORIZATION TO CONSTRUCT / OPERATION PERMIT / EXISTING SYSTEM INSPECTION

PERMIT# 146774 PIN# 4649654752 DATE 12-20-07

OWNER OR APPLICANT Lally Construction PHONE: Business 252-3018 Home

ADDRESS 157 Seal Trail Dr Mooresville NC 28117

LOCATION Hwy 115 R Powerhouse Lp R Rankin Hill TR L Laramie Ct at end on Rt

SUBDIVISION Magic Forest BLOCK / SECTION LOT 22 LOT AREA 1 acre SITE CLASS. PS DESIGN FLOW 360 L.T.A.R. .25

Septic Tank: 1000 Gallons: STB 794 Date 7/2/08
Pump Tank: 1000 Gallons: PT 27 Date 4/6/08
Pump Make: Model Serial No.
Nitrification Field, No Fields 1 Square Feet 1080' Linear Feet 360'
No Lines 3 @ 120' Trench Width 36" Max Trench Bottom Depth 36"


☒ New System ☐ Repair ☐ Expansion System Type: I II III IV V VI
System Description: pm - 25% Reduction
Repair System Description: Same
Maintenance Agreement Required: ☐ Yes ☒ No

☒ House/Mod. Home No. Bedrooms 3
☐ Mobile Home No. Persons
☐ Business No. Employees
☐ Other

Water Supply: ☒ Individual ☐ Public ☐ Community

Gravel Depth N/A ☐ Gravity ☒ Pressure ☐ Slab ☒ Crawl Space ☐ Basement w/plumbing ☐ Basement wo/plumbing

Comments:/Conditions: Scale 1:50'

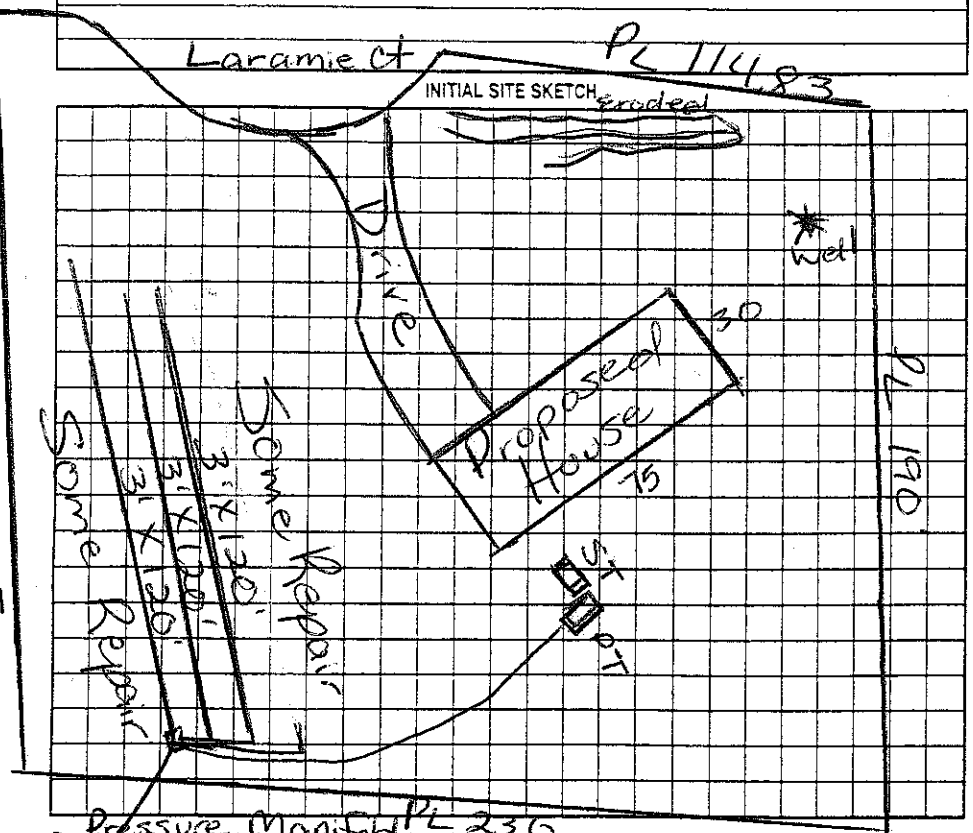

Comments:/Conditions: Stay 100ft from well with Drainfield

TANKS LOCATED BEHIND HOUSE

AS BUILT SKETCH

Permit can be suspended or revoked if any false information is supplied toward securing the permit/any unauthorized changes are made to the site/any unauthorized changes are made in the installation of the system. Improvement Permit with plan valid without expiration ☐ Improvement Permit with site plan valid for sixty months ☐ Authorization to Construct is valid for a period equal to that of Improvement Permit – not to exceed sixty months.

Signed: date 1-14-08

Improvement Permit by: RS date 12/20/07

Authorization to Construct by: RS date 3/12/08

Installed by: Little Hawkins

Operation Permit by: 11-28-11 date

Existing System Inspection by: date

HEALTH DEPT. COPY: WHITE OWNER COPY (FINAL): YELLOW OWNER COPY (INITIAL): PINK