IREDELL COUNTY HEALTH DEPARTMENT

STATESVILLE 704-878-5305 MOORESVILLE 704-664-5281

IMPROVEMENT PERMIT / AUTHORIZATION TO CONSTRUCT / OPERATION PERMIT / EXISTING SYSTEM INSPECTION

PERMIT# 80210 PIN# ~~4664644 PT~~ 4649656915 DATE 4/28/99

OWNER OR CONTRACTOR PIEDMONT HOUSING PHONE: Business 528-7120 Home

ADDRESS 1040 CHARLOTTE HWY

LOCATION 115 N- TL FLOWERHOUSE - TL RANKIN HILL - TL WINDSTAR ON LT

SUBDIVISION WESTWINDS BLOCK / SECTION 3 LOT 30 LOT AREA .73AC SITE CLASS. 2S DESIGN FLOW 360 L.T.A.R.

Septic Tank: 1000 Gallons; STB 1012 Date 3/16/99

Pump Tank: Gallons; PT Date

Pump Make: Model Serial No.

Nitrification Field: No Fields 1 Square Feet 400 Linear Feet 300

No Lines 4@75 Trench Width 36" Max Trench Bottom Depth 36" Gravel Depth N/A

☑ New System ☐ Repair System Type: I, II, III, IV, V, VI

System Description: GRAVITY 25% REDUCTION

Repair System Description: DANCE

Maintenance Agreement Required: ☐ Yes ☑ No

☐ House/Mod. Home ☑ Mobile Home ☐ Business ☐ Other

No. Bedrooms 3 No. Bathrooms 2 No. Employees


☐ Slab ☑ Crawl Space ☐ Basement w/plumbing ☐ Basement wo/plumbing

Water Supply: ☑ Individual ☐ Public ☐ Community


Comments:/Conditions:

Comments:/Conditions:

INITIAL SITE SKETCH 1"=50'

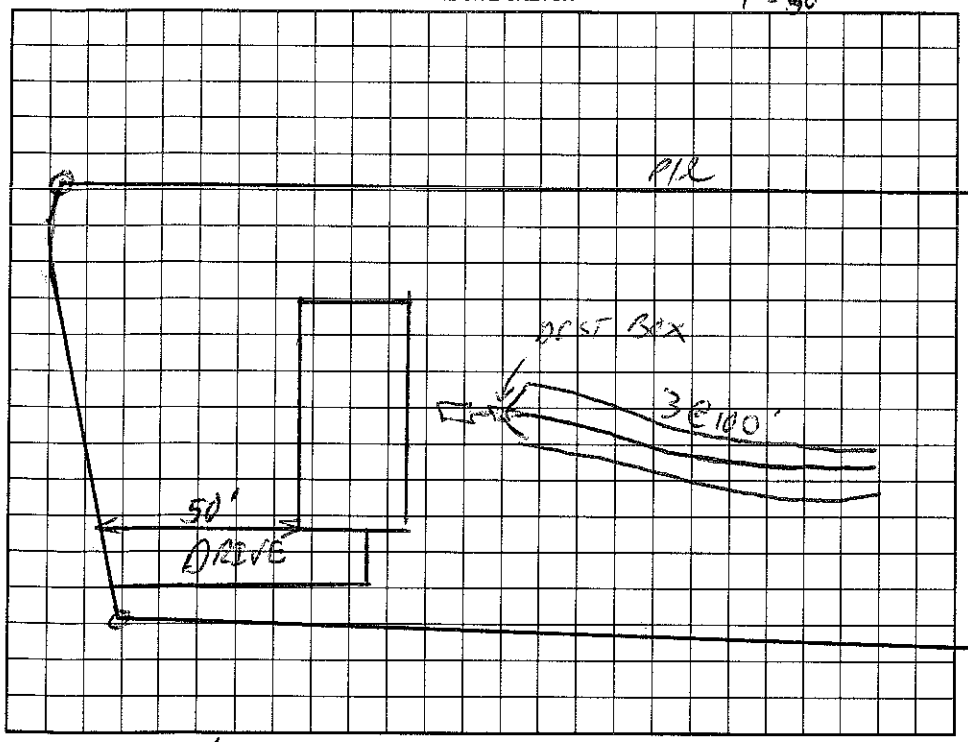

AS BUILT SKETCH

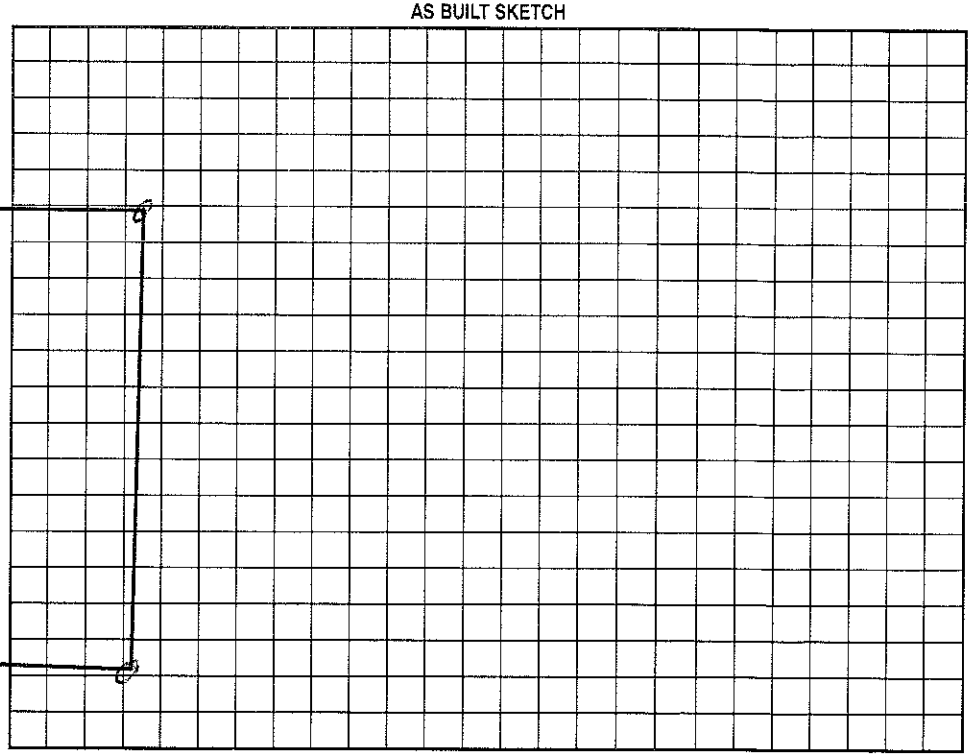

Permit can be suspended or revoked if any false information is supplied toward securing the permit/any unauthorized changes are made to the site/any unauthorized changes are made in the installation of the system. Improvement Permit with plat valid without expiration. Improvement Permit with site plan valid for sixty months. Authorization to Construct is valid for a period equal to that of Improvement Permit – not to exceed sixty months.

Signed: date 4-29-99 Installed by: A-1 Backhoe

Improvement Permit by: RS date 4/28/99 Operation Permit by: Jeff Morgan date 5/7/99

Authorization to Construct by: RS date 4/28/99 Existing System Inspection by: date

HEALTH DEPT. COPY: WHITE OWNER COPY (FINAL): YELLOW OWNER COPY (INITIAL): PINK