IREDELL COUNTY HEALTH DEPARTMENT

STATESVILLE 704-878-5305 25.00 Paid MOORESVILLE 704-664-5281

IMPROVEMENT PERMIT / AUTHORIZATION TO CONSTRUCT / OPERATION PERMIT / EXISTING SYSTEM INSPECTION

PERMIT# 10411 PIN# ~~4649-75-0566.B~~ 4649-65-7022 DATE August 9, 02

OWNER OR CONTRACTOR Grimestar Properties / FLEETWOOD HOMES PHONE: Business _____ Home _____

ADDRESS 1709 S. Main Kannapolis, N.C. 28081

LOCATION 115-21N TL Flower House Loop TL Rankin Hill Rd. TR Ty-Lin Way on left

SUBDIVISION Magic Forest BLOCK / SECTION _____ LOT 8 LOT AREA .73Ac SITE CLASS. T5 DESIGN FLOW 360gpd L.T.A.R. .3

Septic Tank: 1060 Gallons; STB 1812 Date 5/5/03

Pump Tank: _____ Gallons; PT _____ Date _____

Pump Make: _____ Model _____ Serial No. _____

Nitrification Field: No Fields 1 Square Feet 1200 Linear Feet 400

No Lines 4@100' Trench Width 36" Max Trench Bottom Depth 36" Gravel Depth 12"

☑ New System ☐ Repair System Type: I (II) III. IV. V. VI

System Description: Gravity conventional

Repair System Description: GRAV-pumped 25% Reduction

Maintenance Agreement Required: ☐ Yes ☑ No

☐ House/Mod. Home, No. Bedrooms 3

☑ Mobile Home DW No. Bathrooms 2

☐ Business No. Employees _____

☐ Other _____

☐ Slab ☑ Crawl Space ☐ Basement w/plumbing ☐ Basement wo/plumbing


Water Supply: ☑ Individual ☐ Public ☐ Community

Comments/Conditions:

Comments/Conditions:

1"=50'

INITIAL SITE SKETCH

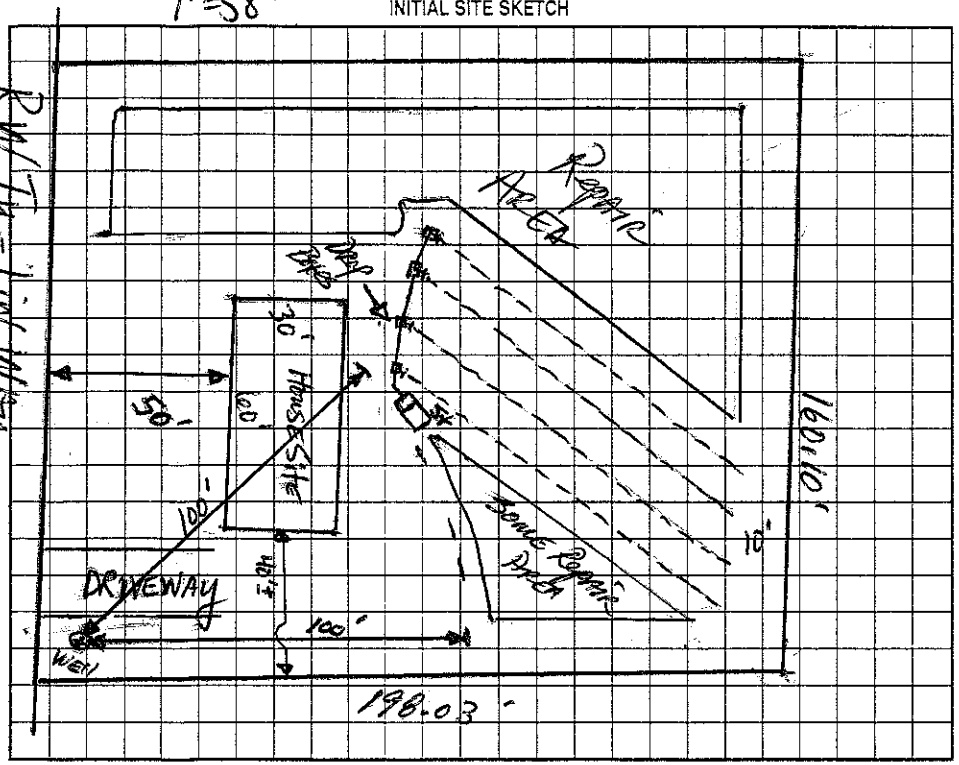

AS BUILT SKETCH

Installed AS Drawn

Permit can be suspended or revoked if any false information is supplied toward securing the permit/any unauthorized changes are made to the site/any unauthorized changes are made in the installation of the system. Improvement Permit with plat valid without expiration. Improvement Permit with site plan valid for sixty months. Authorization to Construct is valid for a period equal to that of Improvement Permit – not to exceed sixty months.

Signed: _____ date 8-16-02 Installed by: Craig Thompson

Improvement Permit by: _____ date 8-9-02 Operation Permit by: _____ date 11/4/03

Authorization to Construct by: _____ date 10/7/03 Existing System Inspection by: _____ date _____

HEALTH DEPT. COPY: WHITE OWNER COPY (FINAL): YELLOW OWNER COPY (INITIAL): PINK