IREDELL COUNTY HEALTH DEPARTMENT

STATESVILLE 704-878-5305 MOORESVILLE 704-664-5281

IMPROVEMENT PERMIT / AUTHORIZATION TO CONSTRUCT / OPERATION PERMIT / EXISTING SYSTEM INSPECTION

PERMIT# ~~10414~~ 180635 PIN# ~~4649-75-0566.15~~ 4649657225 DATE 1/19/05

OWNER OR CONTRACTOR Clayton Homes PHONE: Business 704-895-4622 Home

ADDRESS 1631 5F North Cross Dr. Statesville NC

LOCATION 115/21 N, TL Flowerhouse Ln, TL Rankin Hill, TR Ty-Lin Way on Rt

SUBDIVISION Magic Forest BLOCK / SECTION LOT 15 LOT AREA 0.654c SITE CLASS. PS DESIGN FLOW 360 L.T.A.R. 0.5

Septic Tank: 1000 Gallons; STB 760 Date 4-20-13

Pump Tank: Gallons; PT Date

Pump Make: Model Serial No.

Nitrification Field: No. Fields 1 Square Feet 900 Linear Feet 300'

No. Lines 5@60' Trench Width 36" Max Trench Bottom Depth 36" Gravel Depth —

☒ New System ☐ Repair System Type: I, II, III, IV, V, VI

System Description: Gravity 25% Reduct

Repair System Description: LPP Panel Block

Maintenance Agreement Required: ☐ Yes ☒ No

☒ House/Mod. Home ☐ Mobile Home ☐ Business ☐ Other

No. Bedrooms 3 No. Bathrooms No. Employees


☐ Slab ☒ Crawl Space ☐ Basement w/plumbing ☐ Basement wo/plumbing

Water Supply: ☒ Individual ☐ Public ☐ Community

Comments:/Conditions:

Comments:/Conditions:

INITIAL SITE SKETCH

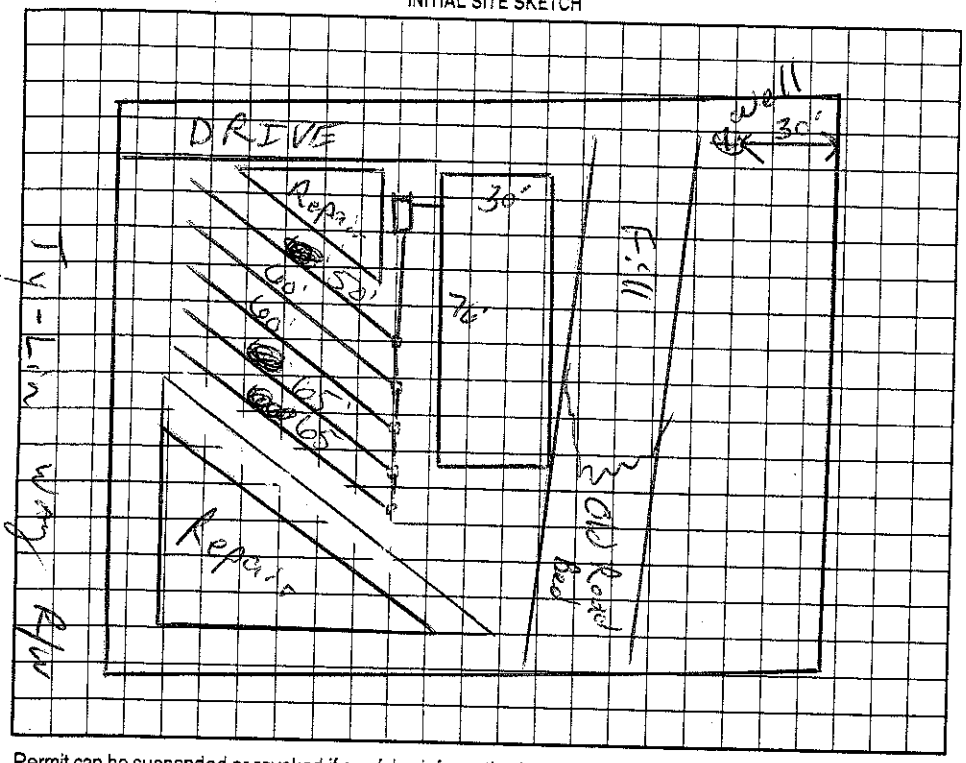

AS BUILT SKETCH

ARC 36 INSTALLED
INSTALLED AS SHOWN

Permit can be suspended or revoked if any false information is supplied toward securing the permit/any unauthorized changes are made to the site/any unauthorized changes are made in the installation of the system. Improvement Permit with plat valid without expiration. Improvement Permit with site plan valid for sixty months. Authorization to Construct is valid for a period equal to that of Improvement Permit – not to exceed sixty months.

Signed: David Hughes date 1/20/05 Installed by: Tim ABBEE

Improvement Permit by: RS date 1/19/05 Operation Permit by: RA date 9-12-13

Authorization to Construct by: RS date 1/19/05 Existing System Inspection by: date

(HEALTH DEPT. COPY: WHITE OWNER COPY (FINAL): YELLOW OWNER COPY (INITIAL): PINK