IREDELL COUNTY HEALTH DEPARTMENT

STATESVILLE 704-878-5305 MOORESVILLE 704-664-5281

IMPROVEMENT PERMIT / AUTHORIZATION TO CONSTRUCT / OPERATION PERMIT / EXISTING SYSTEM INSPECTION

PERMIT# 50209 PIN# ~~4649666644 PT~~ 4649657913 DATE 4/28/99

OWNER OR CONTRACTOR PIEDMONT HOUSING PHONE: Business 528-7120 Home

ADDRESS 1040 CHARLOTTE HWY TROUTMAN NC 28166

LOCATION 115 N - TL FLOWER HOUSE - TL RANKIN HILL - TR GAYLE - ON LT

SUBDIVISION WESTWINDS BLOCK / SECTION 2 LOT 29 LOT AREA .57AC SITE CLASS. PS DESIGN FLOW 360 L.T.A.R. .3

Septic Tank: 1000 Gallons; STB 1012 Date 3/16/99
Pump Tank: ____ Gallons; PT ____ Date ____
Pump Make: ____ Model ____ Serial No. ____
Nitrification Field: No Fields 1 Square Feet 700 Linear Feet 300
No Lines 3@100' Trench Width 36" Max Trench Bottom Depth 36" Gravel Depth N/A

~~New System~~ ☐ Repair System Type: I, II, III, IV, V, VI
System Description: GRAVITY EZLAY
Repair System Description: SAME
Maintenance Agreement Required: ☐ Yes ~~No~~


☐ House/Mod. Home No. Bedrooms 3
~~Mobile Home~~ No. Bathrooms 3
☐ Business No. Employees ____
☐ Other ____
☐ Slab ~~Crawl Space~~ ☐ Basement w/plumbing ☐ Basement wo/plumbing

Water Supply:
~~Individual~~
☐ Public
Community

Comments:/Conditions:

Comments:/Conditions:

INITIAL SITE SKETCH 1"=50'

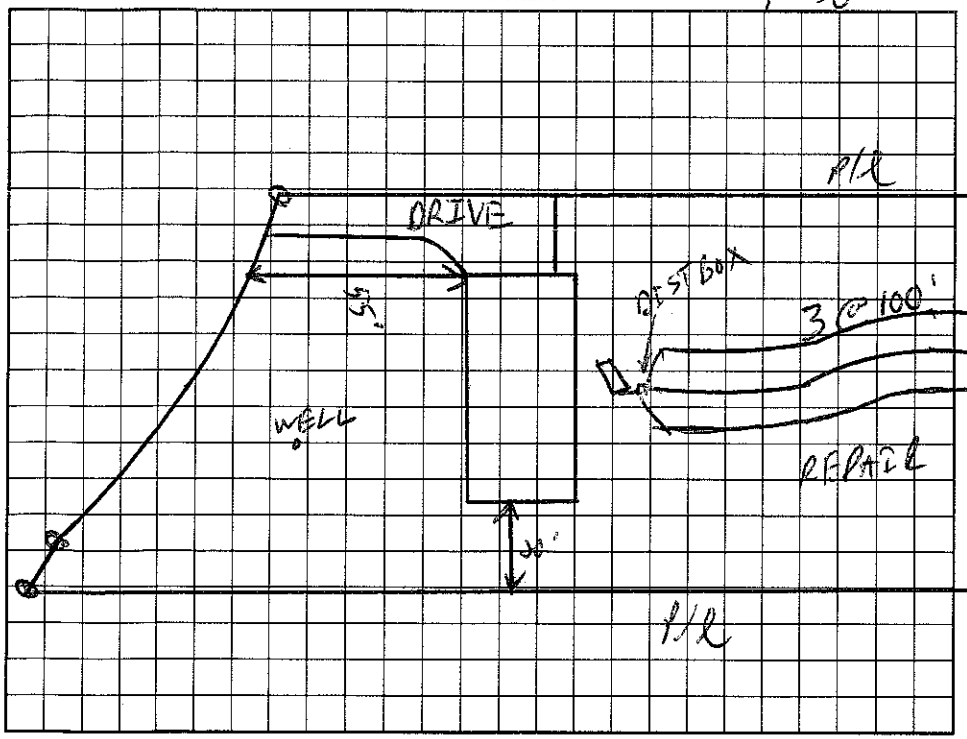

AS BUILT SKETCH

Permit can be suspended or revoked if any false information is supplied toward securing the permit/any unauthorized changes are made to the site/any unauthorized changes are made in the installation of the
Permit with plat valid without expiration. Improvement Permit with site plan valid for sixty months. Authorization to Construct is valid for a period equal to that of Improvement Permit – not to exceed sixty

Signed: ____ date 4-29-99 Installed by: A-1 Backhoe

Improvement Permit by: C. [illegible] RS date 4/28/99 Operation Permit by: Jeff Morgan

Authorization to Construct by: C. [illegible] RS date 4/28/99 Existing System Inspection by: ____

HEALTH DEPT. COPY: WHITE OWNER COPY (FINAL): YELLOW OWNER COPY (INITIAL): PINK