IREDELL COUNTY HEALTH DEPARTMENT

STATESVILLE 704-878-[illegible] 50.00 Paid 3030 40-

MOORESVILLE 704-664-5281

IMPROVEMENT PERMIT / AUTHORIZATION TO CONSTRUCT / OPERATION PERMIT / EXISTING SYSTEM INSPECTION

PERMIT# 105409 PIN# ~~4649-75-0566.24~~ 4649-65-8730 DATE 5/19/03

OWNER OR CONTRACTOR Piedmont Charlotte Dev. PHONE: Business 704-902-1836 Home

ADDRESS 134 KOA Ln. Statesville NC 28677

LOCATION 115-21 N, TL Flowerhouse Lp, TL Rankin Hill, TR Laramie ct On Rt

SUBDIVISION Magic Forest BLOCK / SECTION 3 LOT 24 LOT AREA 0.72 Ac SITE CLASS. PS DESIGN FLOW 480 L.T.A.R. 0.5

Septic Tank: 1000 Gallons; STB 1012 Date 10/9/02

Pump Tank: Gallons; PT Date

Pump Make: Model Serial No.

Nitrification Field: No Fields 1 Square Feet 1200 Linear Feet 400

No Lines 5@80' Trench Width 36" Max Trench Bottom Depth 36" Gravel Depth —

☒ New System ☐ Repair System Type: I, II, (III), IV, V, VI

System Description: Gravity 25% Reduct.

Repair System Description: OLP Panel Block

Maintenance Agreement Required: ☐ Yes ☒ No

☐ House/Mod. Home ☒ Mobile Home ☐ Business ☐ Other

No. Bedrooms 4 No. Bathrooms 2 No. Employees

☐ Slab ☒ Crawl Space ☐ Basement w/plumbing ☐ Basement wo/plumbing


Water Supply: ☒ Individual ☐ Public ☐ Community

Comments:/Conditions:

1" = 50'

Comments:/Conditions:

INITIAL SITE SKETCH

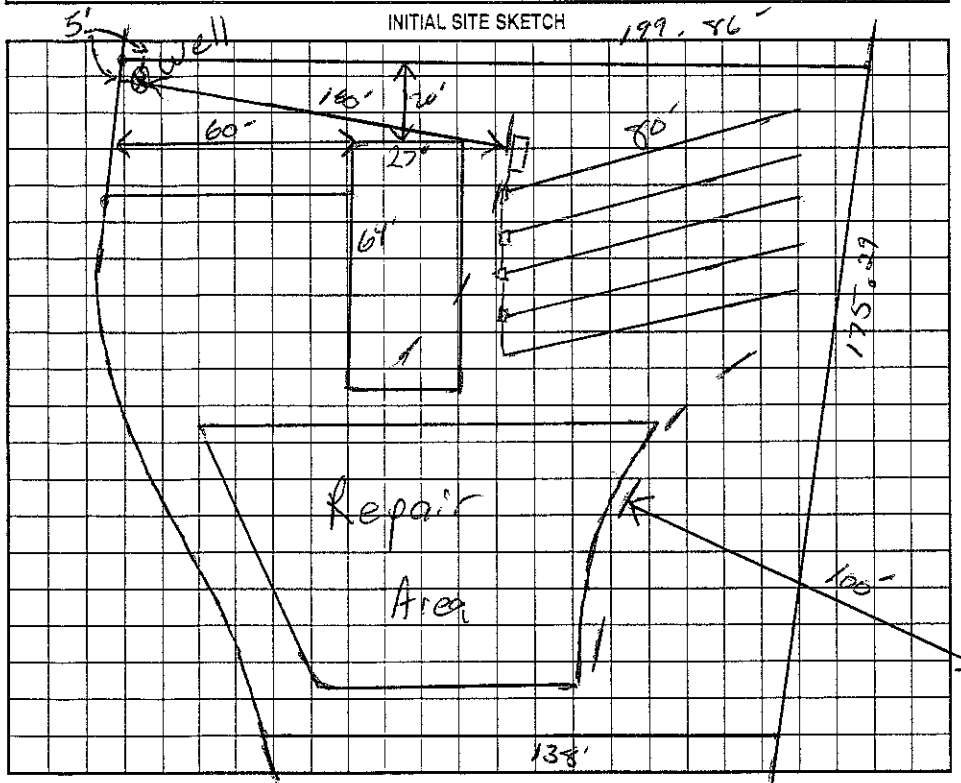

AS BUILT SKETCH

Infiltrators Installed

As Drawn

Permit can be suspended or revoked if any false information is supplied toward securing the permit/any unauthorized changes are made to the site/any unauthorized changes are made in the installation of the system. Improvement Permit with plat valid without expiration. Improvement Permit with site plan valid for sixty months. Authorization to Construct is valid for a period equal to that of Improvement Permit – not to exceed sixty months.

Signed: Jacob A Smith date ~~20~~ May 03

Improvement Permit by: RS date 5/19/03

Authorization to Construct by: RS date 5/19/05

Installed by: A-1 Backhoe

Operation Permit by: RS date 5/30/03

Existing System Inspection by: date

HEALTH DEPT. COPY: WHITE OWNER COPY (FINAL): YELLOW OWNER COPY (INITIAL): PINK