IREDELL COUNTY HEALTH DEPARTMENT

STATESVILLE 704-878-5305 MOORESVILLE 704-664-5281

IMPROVEMENT PERMIT / AUTHORIZATION TO CONSTRUCT / OPERATION PERMIT / EXISTING SYSTEM INSP

PERMIT# 80212 PIN# ~~4649666644~~ PT 4649 66 4469 DATE 4/15/99

OWNER OR CONTRACTOR PIEDMONT HOUSING PHONE: Business _____ Home 528-7120

ADDRESS 1040 CHARLOTTE HWY - TROUTMAN NC 28166

LOCATION 115 N - TL FLOWERHOUSE - TL RANGER HILL - TR GAGE ON LT

SUBDIVISION WESTWINDS BLOCK / SECTION 2 LOT 38 LOT AREA .61AC SITE CLASS. PS DESIGN FLOW 360GPD L.T.A.R. .3 GPD/FT²

Septic Tank: 1000 Gallons; STB 1812 Date 3/19/99

Pump Tank: _____ Gallons; PT _____ Date _____

Pump Make: _____ Model _____ Serial No. _____

Nitrification Field: No Fields 1 Square Feet 900 Linear Feet 300

No Lines 4@75' Trench Width 36" Max Trench Bottom Depth 36" Gravel Depth N/A

☑ New System ☐ Repair System Type: I, II, III, IV, V, VI

System Description: GRAVITY EZFLAY

Repair System Description: SAME

Maintenance Agreement Required: ☐ Yes ☑ No

☑ House/Mod. Home No. Bedrooms 3

☐ Mobile Home No. Bathrooms 2

☐ Business No. Employees ____

☐ Other _____


☐ Slab ☑ Crawl Space ☐ Basement w/plumbing ☐ Basement wo/plumbing

Water Supply: ☑ Individual ☐ Public ☐ Community


Comments:/Conditions:

Comments:/Conditions:

INITIAL SITE SKETCH

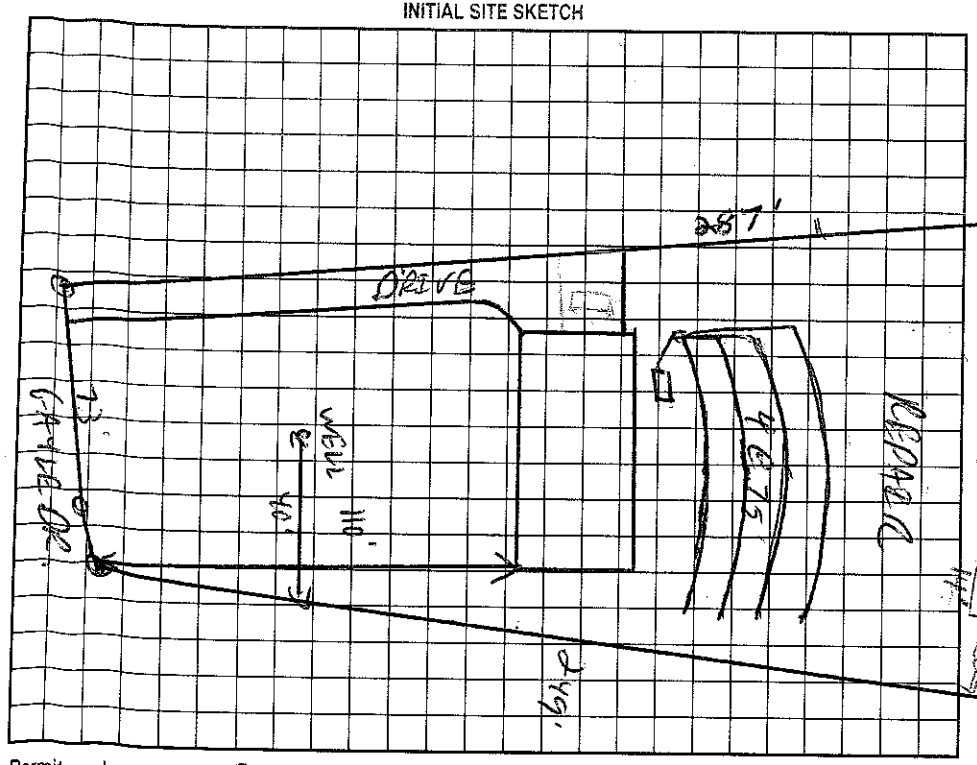

AS BUILT SKETCH

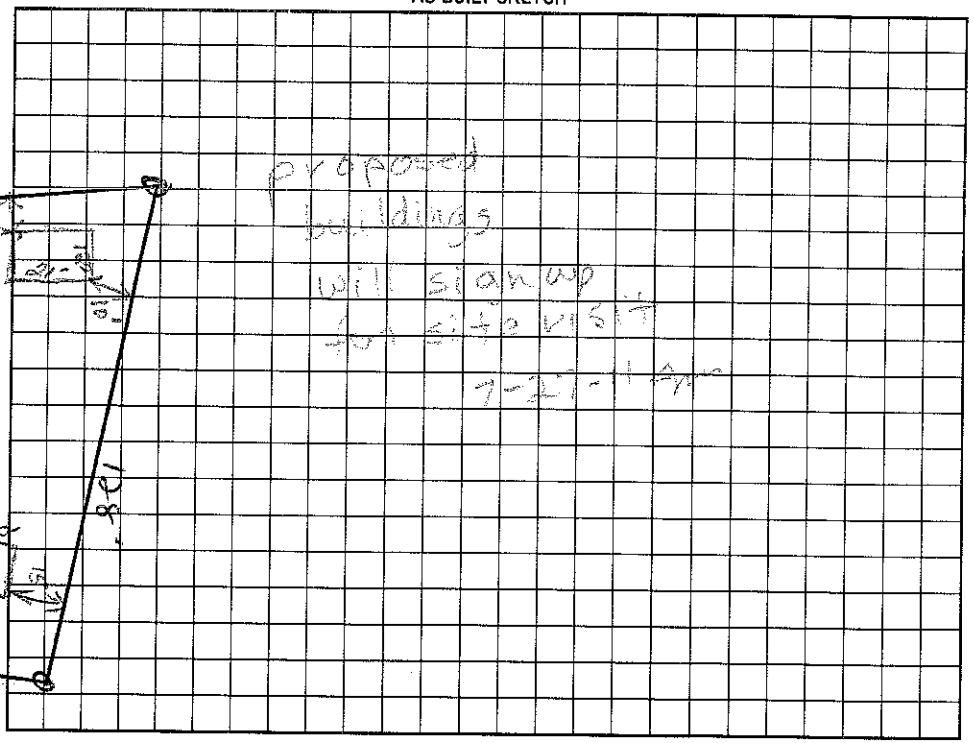

Permit can be suspended or revoked if any false information is supplied toward securing the permit/any unauthorized changes are made to the site/any unauthorized changes are made in the installation of the system. Improvement Permit with plat valid without expiration. Improvement Permit with site plan valid for sixty months. Authorization to Construct is valid for a period equal to that of Improvement Permit – not to exceed sixty months.

Signed: _____ date 4-26-99 Installed by: A1 BACKHOE

Improvement Permit by: C. _____ RS date 4/15/99 Operation Permit by: C. _____ date 5/7/99

Authorization to Construct by: C. _____ RS date 4/15/99 Existing System Inspection by: _____ date _____

HEALTH DEPT. COPY: WHITE OWNER COPY (FINAL): YELLOW OWNER COPY (INITIAL): PINK