IREDELL COUNTY HEALTH DEPARTMENT

STATESVILLE 704-878-5305 MOORESVILLE 704-664-5281

IMPROVEMENT PERMIT / AUTHORIZATION TO CONSTRUCT / OPERATION PERMIT / EXISTING SYSTEM INSPECTION

PERMIT# 80213 PIN# ~~4649666441~~ 4649606460 DATE 4/15/99

OWNER OR CONTRACTOR PIEDMONT HOUSING PHONE: Business _____ Home 525-7120

ADDRESS 1040 CHARLOTTE HWY

LOCATION 119 N - TL FLOWERHOUSE - TL RANKIN - TO GAGE - ON RT

SUBDIVISION WESTWINDS BLOCK / SECTION 2 LOT 39 LOT AREA 1 AC SITE CLASS PS DESIGN FLOW 360 L.T.A.R. .3 600 FT²

Septic Tank: 1000 Gallons; STB 1012 Date 3/12/99

Pump Tank: _____ Gallons; PT _____ Date _____

Pump Make: _____ Model _____ Serial No. _____

Nitrification Field: No Fields 1 Square Feet 900 Linear Feet 300

No Lines 4@75 Trench Width 36" Max Trench Bottom Depth 36" Gravel Depth N/A

☑ New System ☐ Repair System Type: I, II, (III) IV, V, VI

System Description: GRAVITY 25% REDUCTION

Repair System Description: PANEL

Maintenance Agreement Required: ☐ Yes ☑ No

☑ House/Mod. Home No. Bedrooms 3

☐ Mobile Home No. Bathrooms 2

☐ Business No. Employees _____

☐ Other _____


☐ Slab ☑ Crawl Space ☐ Basement w/plumbing ☐ Basement wo/plumbing

Water Supply: ☑ Individual ☐ Public ☐ Community

Comments:/Conditions: LOT 39

Comments:/Conditions:

INITIAL SITE SKETCH

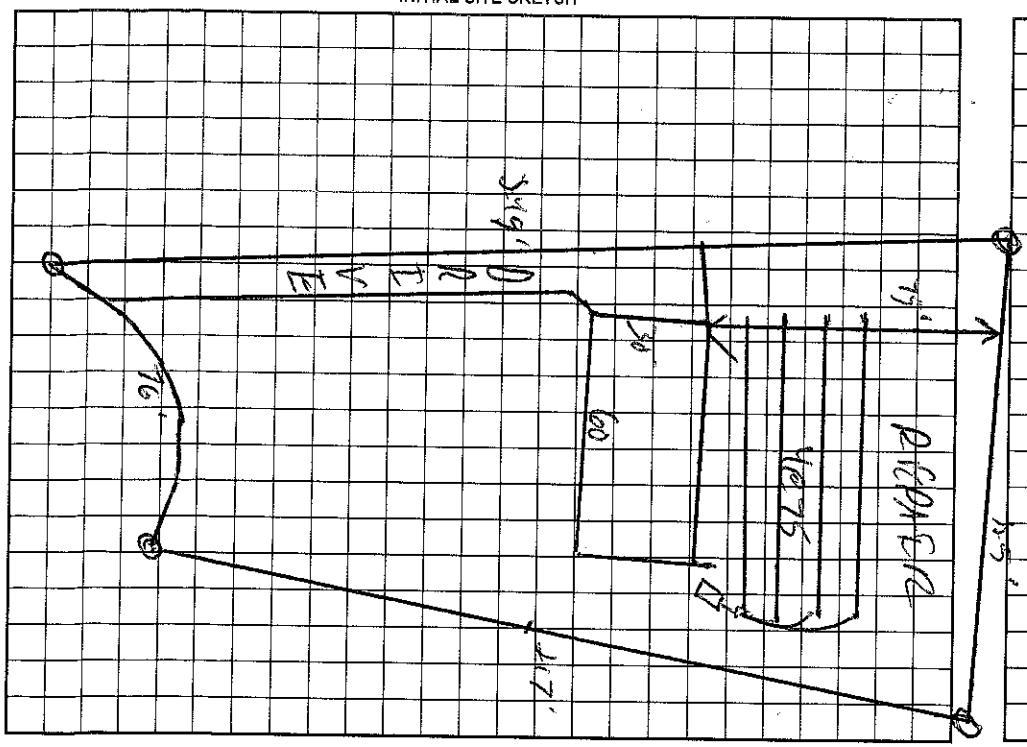

AS BUILT SKETCH

Permit can be suspended or revoked if any false information is supplied toward securing the permit/any unauthorized changes are made to the site/any unauthorized changes are made in the installation of the system. Improvement Permit with plat valid without expiration. Improvement Permit with site plan valid for sixty months. Authorization to Construct is valid for a period equal to that of Improvement Permit – not to exceed sixty months.

Signed: _____ date 4-26-99 Installed by: AL BAUGHER

Improvement Permit by: C. Hyatt RS date 4/15/99 Operation Permit by: C. Hyatt date 5/7/99

Authorization to Construct by: C. Hyatt RS date 4/15/99 Existing System Inspection by: _____ date _____

HEALTH DEPT. COPY: WHITE OWNER COPY (FINAL): YELLOW OWNER COPY (INITIAL): PINK