10.45

IREDELL COUNTY HEALTH DEPARTMENT

STATESVILLE 704-878-5305 MOORESVILLE 704-664-5281

IMPROVEMENT PERMIT / AUTHORIZATION TO CONSTRUCT / OPERATION PERMIT / EXISTING SYSTEM INSPECTI...

PERMIT# 81930 PIN# ~~4649 66 7891~~ 4649 66 5703 DATE 6/22/99

OWNER OR CONTRACTOR JERRY WILSON PHONE: Business Home 663-2220

ADDRESS 2880 CHARLOTTE HWY - MOORESVILLE NC 28117

LOCATION FLOWER HOUSE - TL RANKEN MILL - TR GALE - AT END

SUBDIVISION WESTWINDS BLOCK / SECTION 2 LOT 40 LOT AREA 1 AC. SITE CLASS. KS DESIGN FLOW 360 L.T.A.R. .3

Septic Tank: 1000 Gallons; STB 102 Date 3/23/99

Pump Tank: Gallons; PT Date

Pump Make: Model Serial No.

Nitrification Field: No Fields 1 Square Feet 900 Linear Feet 300

No Lines 5@60' Trench Width 36" Max Trench Bottom Depth 36" Gravel Depth N/A

☑ New System ☐ Repair System Type: I, II, III, IV, V, VI

System Description: GRAVITY 25% REDUCTION

Repair System Description: SAME / PANEL

Maintenance Agreement Required: ☐ Yes ☑ No

☐ House/Mod. Home ☑ Mobile Home ☐ Business ☐ Other

No. Bedrooms 3 No. Bathrooms 2 No. Employees


Water Supply: ☑ Individual ☐ Public ☐ Community

☐ Slab ☑ Crawl Space ☐ Basement w/plumbing ☐ Basement wo/plumbing

Comments:/Conditions:

1"=50'


INITIAL SITE SKETCH

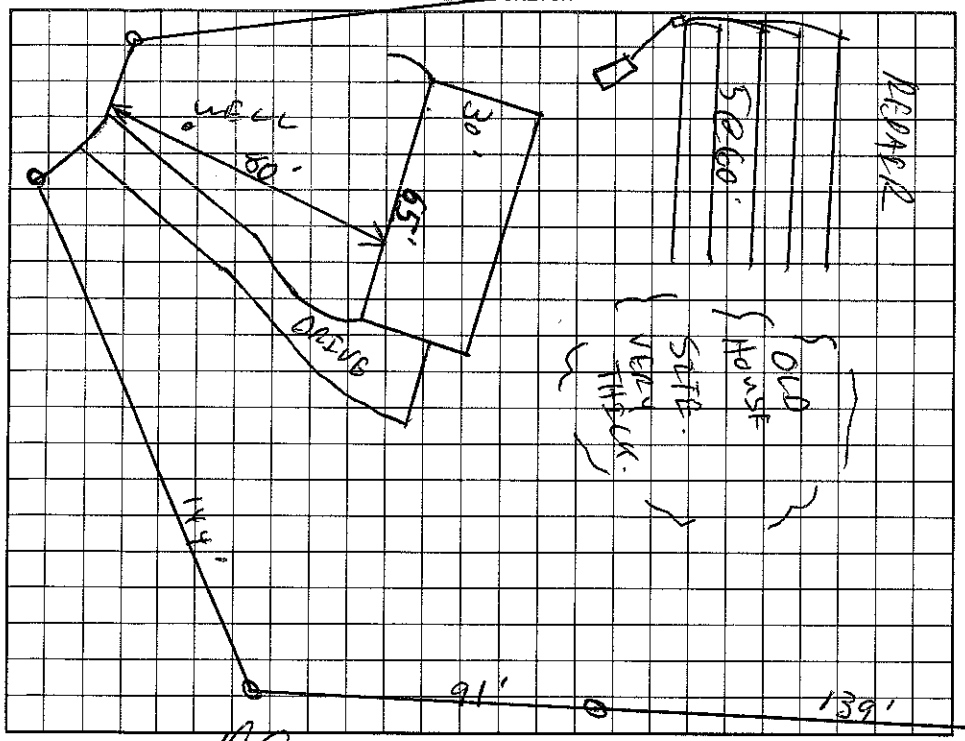

Comments:/Conditions: WELL NOT LOCATED AT INSPECTION

1"=50'

AS BUILT SKETCH

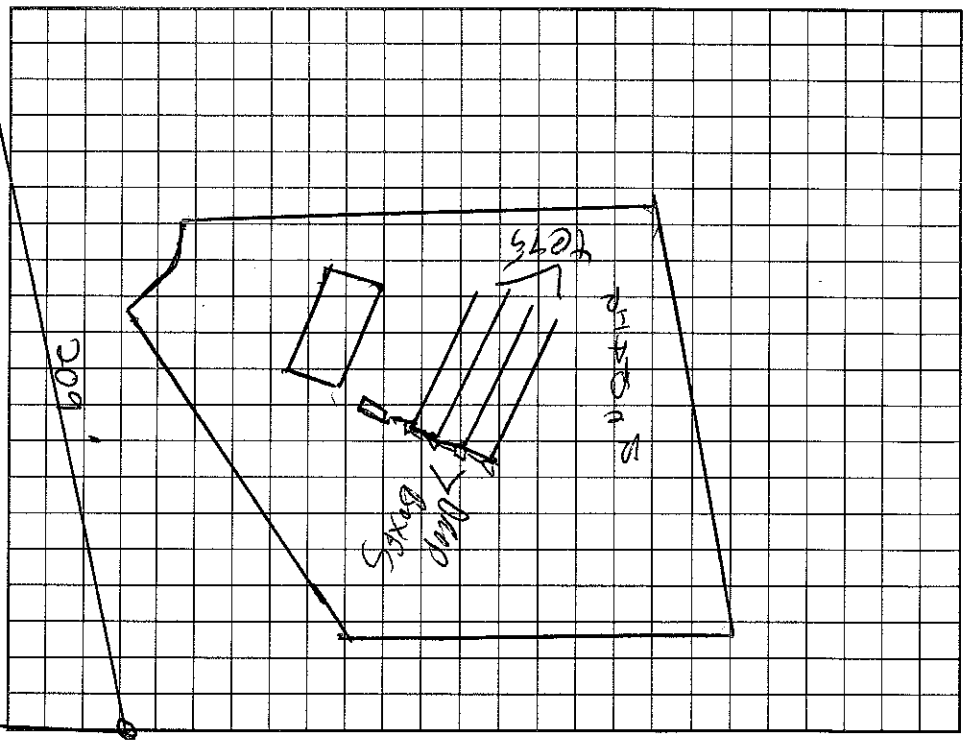

Permit can be suspended or revoked if any false information is supplied toward securing the permit/any unauthorized changes are made to the site/any unauthorized changes are made in the installation of the system. Improvement Permit with plat valid without expiration. Improvement Permit with site plan valid for sixty months. Authorization to Construct is valid for a period equal to that of Improvement Permit – not to exceed sixty months.

Signed: date 6-23-99 Installed by: A1 BACKHOE

Improvement Permit by: C. [signature] RS date 6/23/99 Operation Permit by: C. [signature] date 7/7/99

Authorization to Construct by: C. [signature] RS date 6/23/99 Existing System Inspection by: date

HEALTH DEPT. COPY: WHITE OWNER COPY (FINAL): YELLOW OWNER COPY (INITIAL): PINK