(1:30)

IREDELL COUNTY HEALTH DEPARTMENT

STATESVILLE 704-878-5305 MOORESVILLE 704-664-5281

IMPROVEMENT PERMIT / AUTHORIZATION TO CONSTRUCT / OPERATION PERMIT / EXISTING SYSTEM INSPECTI

PERMIT# 80830 PIN# 4649667891 PT 4649667282 DATE 5/11/99

OWNER OR CONTRACTOR PIEDMONT HOUSING PHONE: Business 525-7120 Home

ADDRESS 1040 CHARLOTTE HWY - TROUTMAN NC 28166

LOCATION 21/115N - TL FLOWER HOUSE - TL RANKEN HILL - TR GAYLE. ON RT

SUBDIVISION WESTWINDS BLOCK / SECTION 2 LOT 42 LOT AREA 1.93AC SITE CLASS. PS DESIGN FLOW 360 L.T.A.R. .3

Septic Tank: 1000 Gallons; STB D13 Date 10-11-99
Pump Tank: 1000 Gallons; PT 17 Date 11-3-99
Pump Make: Liberty Model SK50A1 Serial No.
Nitrification Field: No Fields 1 Square Feet 900 Linear Feet 300
No Lines 4@75' Trench Width 36" Max Trench Bottom Depth 36" Gravel Depth N/A

☑ New System ☐ Repair System Type: I, II, III, IV, V, VI
System Description: PUMP EZ LAY ORIANNA
Repair System Description: SAME
Maintenance Agreement Required: ☐ Yes ☑ No


☐ House/Mod. Home No. Bedrooms 3
☑ Mobile Home No. Bathrooms 2
☐ Business No. Employees
☐ Other
☐ Slab ☑ Crawl Space ☐ Basement w/plumbing ☐ Basement wo/plumbing

Water Supply: ☑ Individual ☐ Public ☐ Community


Comments:/Conditions:

Comments:/Conditions: Lawns & lines inspected 2/7/2000 JM

INITIAL SITE SKETCH

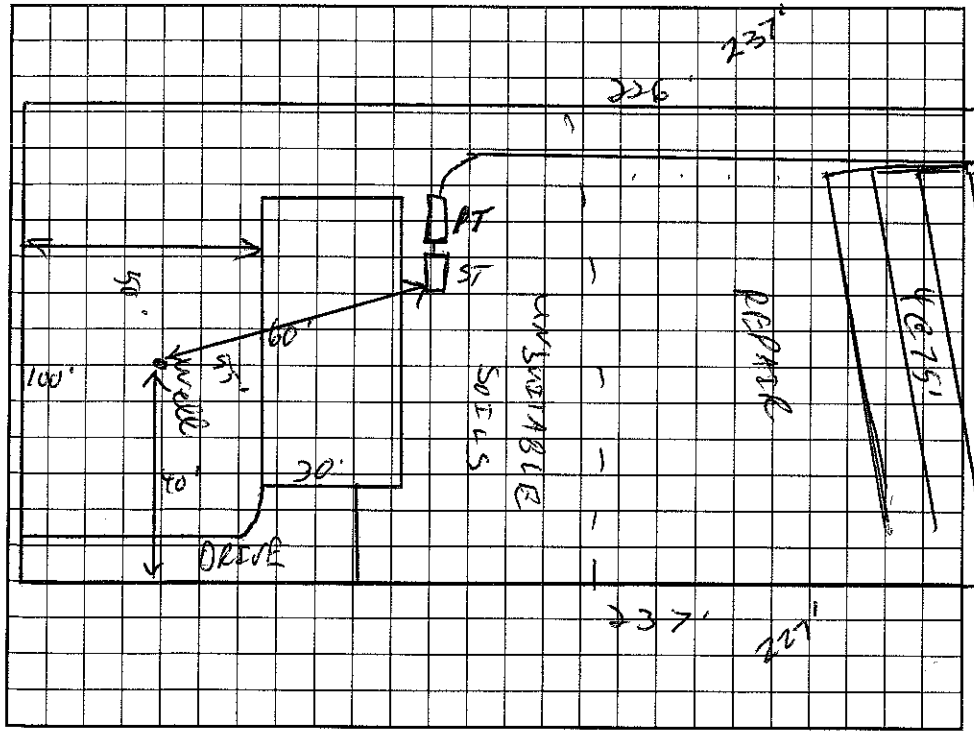

AS BUILT SKETCH

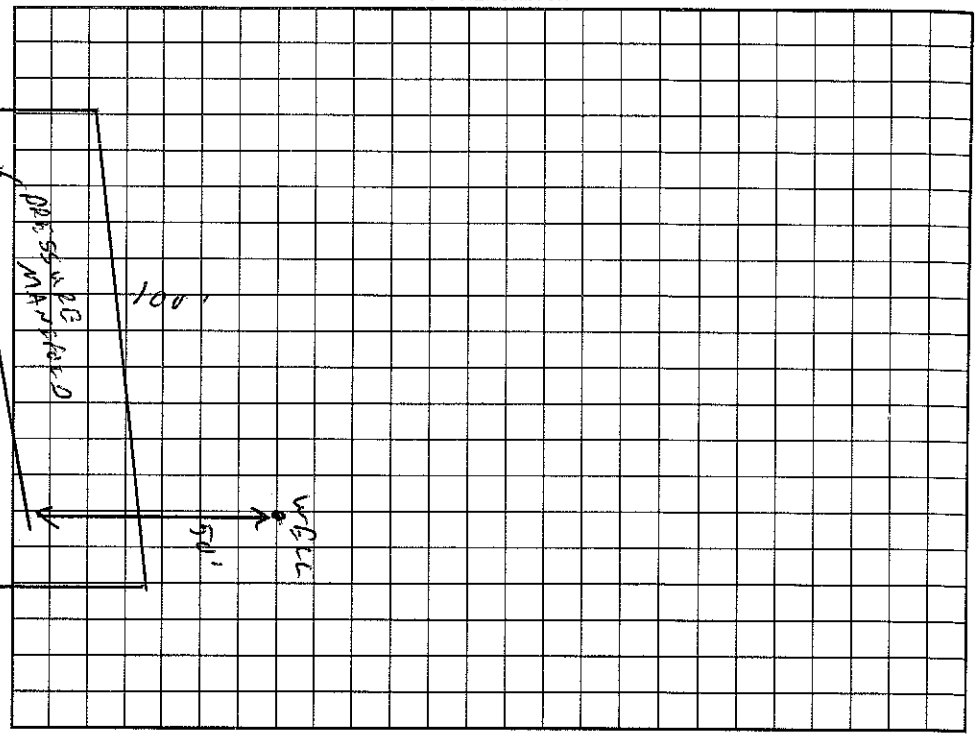

Gayle Dr

Permit can be suspended or revoked if any false information is supplied toward securing the permit/any unauthorized changes are made to the site/any unauthorized changes are made in the installation of the system. Improvement Permit with plat valid without expiration. Improvement Permit with site plan valid for sixty months. Authorization to Construct is valid for a period equal to that of Improvement Permit – not to exceed sixty months.

Signed: Vera Newton date 5-11-99

Improvement Permit by: C. Kyle RS date 5/11/99

Authorization to Construct by: C. Kyle RS date 5/11/99

Installed by: A-1 Backhoe

Operation Permit by: Maria H. Jackson R.S. date 2/24/2000

Existing System Inspection by: date

HEALTH DEPT. COPY: WHITE OWNER COPY (FINAL): YELLOW OWNER COPY (INITIAL): PINK