IREDELL COUNTY HEALTH DEPARTMENT

STATESVILLE 704-878-5305 MOORESVILLE 704-664-5281

IMPROVEMENT PERMIT / AUTHORIZATION TO CONSTRUCT / OPERATION PERMIT / EXISTING SYSTEM INSPECTION

PERMIT# 80831 PIN# 4649667891 PT 4649667362 DATE 5/11/99

OWNER OR CONTRACTOR PIEDMONT HOUSING PHONE: Business _____ Home 525-7120

ADDRESS 1040 CHARLOTTE HWY - TROUTMAN NC 28166

LOCATION 21/115 - TL FLOWER HOUSE NO - TL RANKEN HILL - TR CABLE DR. ON RT NEAR END

SUBDIVISION WESTWINDS BLOCK / SECTION 2 LOT 43 LOT AREA .155AC SITE CLASS. RS DESIGN FLOW 360 L.T.A.R. .3

Septic Tank: 1000 Gallons; STB 1012 Date 3/29/99

Pump Tank: 1000 Gallons; PT 47 Date 2/11/99

Pump Make: _____ Model _____ Serial No. _____

Nitrification Field: No Fields 1 Square Feet 900 Linear Feet 300

No Lines 4@75' Trench Width 36" Max Trench Bottom Depth 36" Gravel Depth N/A

☑ New System ☐ Repair System Type: I, II, (III), IV, V, VI

System Description: PUMP EZ-LAY

Repair System Description: SAME

Maintenance Agreement Required: ☐ Yes ☑ No

☐ House/Mod. Home No. Bedrooms 3

☑ Mobile Home No. Bathrooms 2

☐ Business No. Employees _____

☐ Other _____


☐ Slab ☑ Crawl Space ☐ Basement w/plumbing ☐ Basement wo/plumbing

Water Supply: ☑ Individual ☐ Public ☐ Community


Comments:/Conditions:

Comments:/Conditions:

INITIAL SITE SKETCH 1"=40'

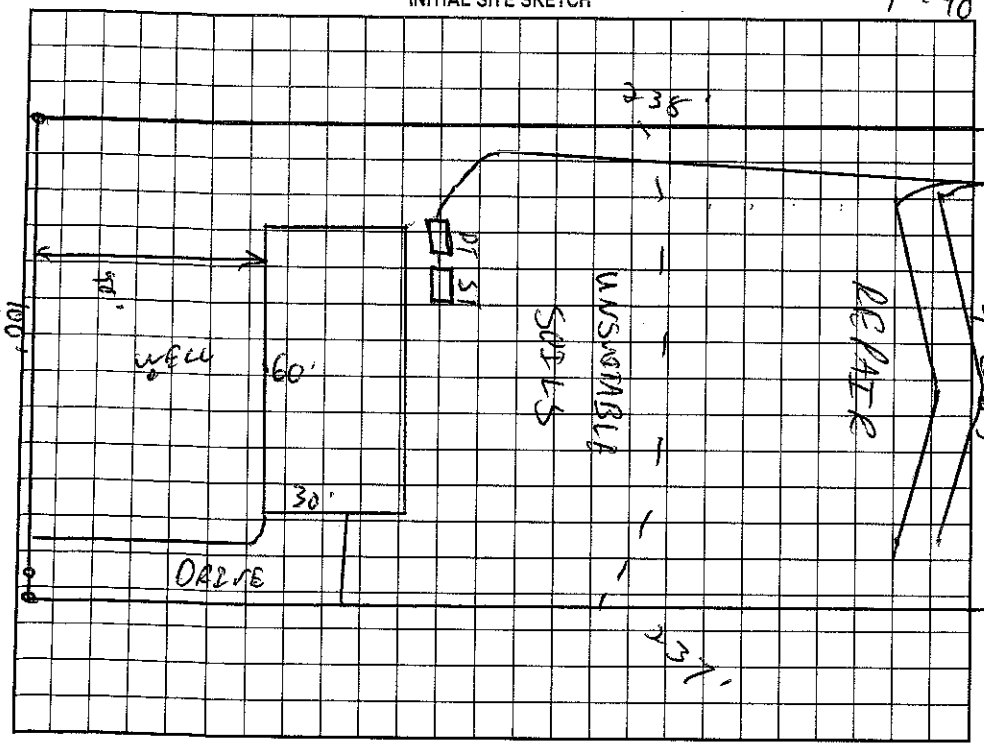

AS BUILT SKETCH

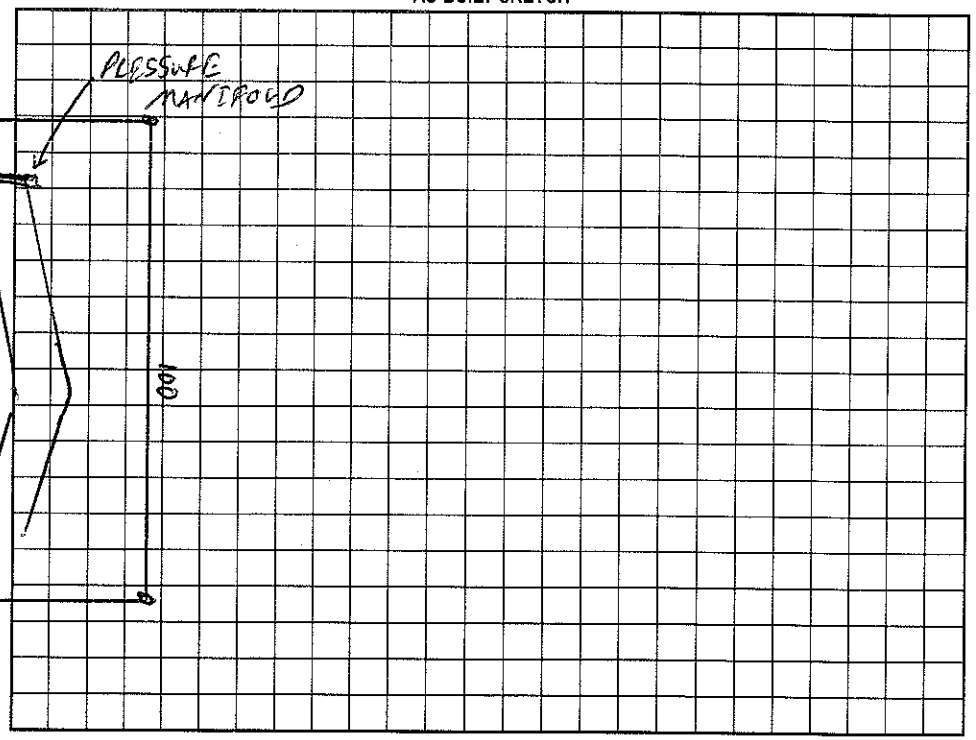

Permit can be suspended or revoked if any false information is supplied toward securing the permit/any unauthorized changes are made to the site/any unauthorized changes are made in the installation of the system. Improvement Permit with plat valid without expiration. Improvement Permit with site plan valid for sixty months. Authorization to Construct is valid for a period equal to that of Improvement Permit – not to exceed sixty months.

Signed: Teresa Clayton date 5-11-99 Installed by: AJ

Improvement Permit by: C. Hyatt KS date 5/11/99 Operation Permit by: Jeff Mayer date 6-23-99

Authorization to Construct by: C. Hyatt KS date 5/11/99 Existing System Inspection by: _____ date _____

HEALTH DEPT. COPY: WHITE OWNER COPY (FINAL): YELLOW OWNER COPY (INITIAL): PINK