IREDELL COUNTY HEALTH DEPARTMENT

STATESVILLE 704-878-5305 MOORESVILLE 704-664-5281

IMPROVEMENT PERMIT / AUTHORIZATION TO CONSTRUCT / OPERATION PERMIT / EXISTING SYSTEM INSPECTION

PERMIT# 8021 4 PIN# ~~4649666644 PF~~ 4649667452 DATE 5/11/99

OWNER OR CONTRACTOR PIEDMONT HOUSING PHONE: Business 528-7120 Home

ADDRESS 1040 CHARLOTTE HWY - TROUTMAN NC 28166

LOCATION 115 N - TL FLOWERHOUSE - TL RANKEN HILL - TL GAGE - ON RT

SUBDIVISION WESTWINDS BLOCK / SECTION 2 LOT 44 LOT AREA .54AC SITE CLASS. LS DESIGN FLOW 360 L.T.A.R. .3

Septic Tank: 1000 Gallons; STB 1015 Date 3/24/99

Pump Tank: Gallons; PT Date

Pump Make: Model Serial No.

Nitrification Field: No Fields 1 Square Feet 900 Linear Feet 300

No Lines 5 @ 60' Trench Width 36" Max Trench Bottom Depth 36" Gravel Depth N/A

☒ New System ☐ Repair System Type: I, II, III, IV, V, VI

System Description: GRAVITY EZFLOW CHAMBERS

Repair System Description: 50 PANEL

Maintenance Agreement Required: ☐ Yes ☒ No

☐ House/Mod. Home No. Bedrooms 3

☐ Mobile Home No. Bathrooms 2

☐ Business No. Employees

☐ Other

☐ Slab ☒ Crawl Space ☐ Basement w/plumbing ☐ Basement wo/plumbing


Water Supply: ☒ Individual ☐ Public ☐ Community

Comments:/Conditions: KEEP WELL AT LEAST 40' OFF ANY PROPERTY LINE.


1" = 40'

Comments:/Conditions:

INITIAL SITE SKETCH

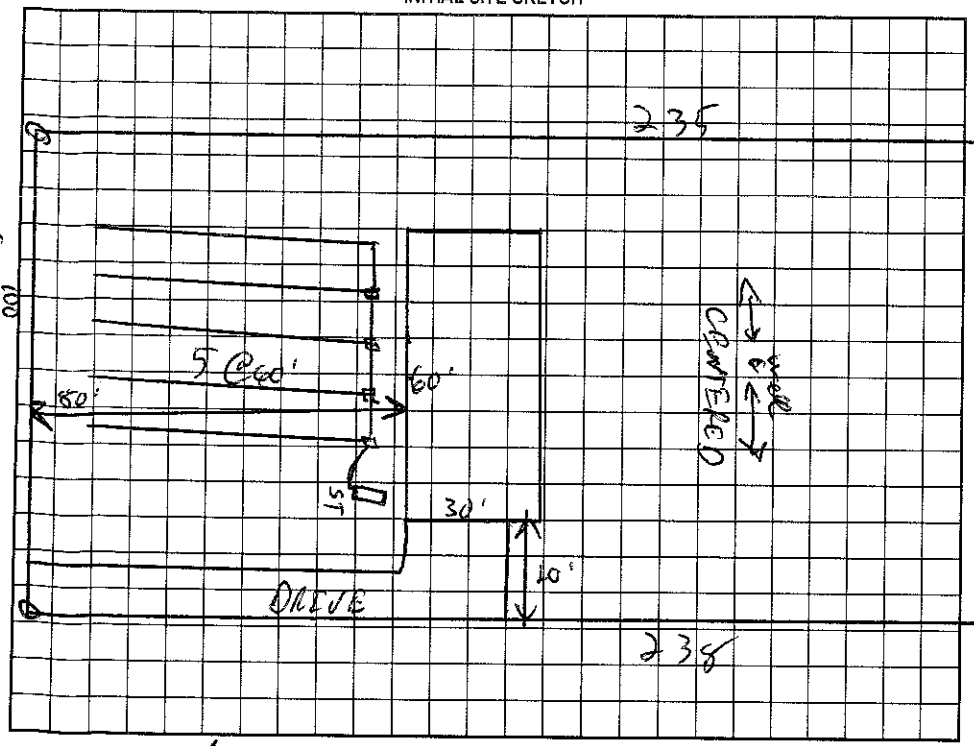

AS BUILT SKETCH

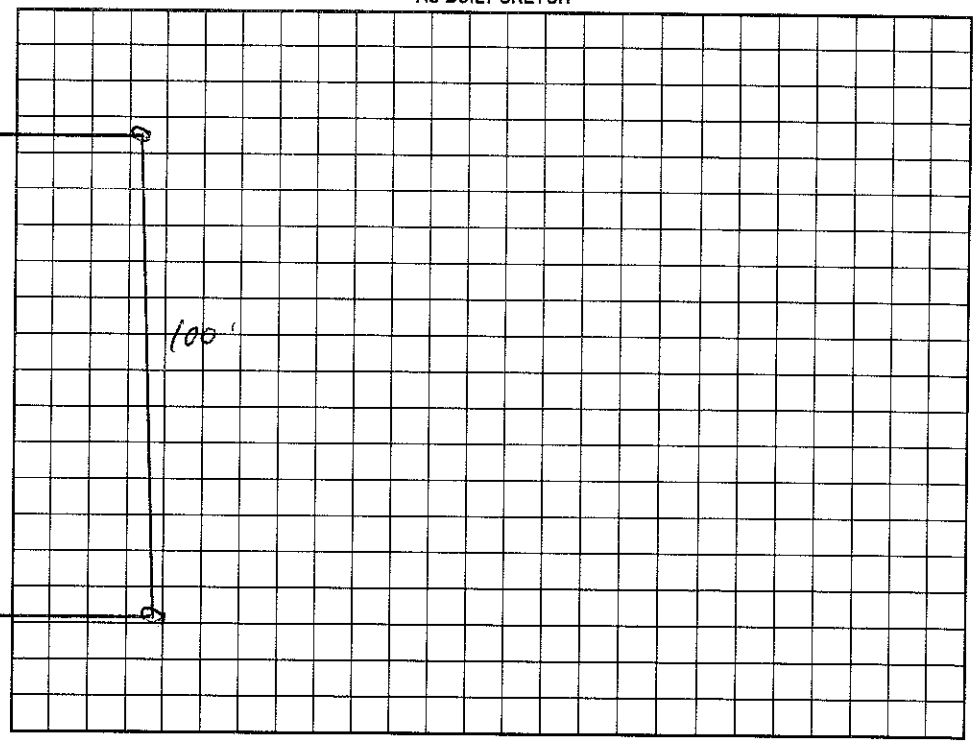

Permit can be suspended or revoked if any false information is supplied toward securing the permit/any unauthorized changes are made to the site/any unauthorized changes are made in the installation of the system. Improvement Permit with plat valid without expiration. Improvement Permit with site plan valid for sixty months. Authorization to Construct is valid for a period equal to that of Improvement Permit – not to exceed sixty months.

Signed: Dawn Newton date 5-11-99 Installed by: A1 BACKHOE

Improvement Permit by: C. RS date 5/11/99 Operation Permit by: C. RS date 5/21/99

Authorization to Construct by: C. RS date 5/11/99 Existing System Inspection by: date

HEALTH DEPT. COPY: WHITE OWNER COPY (FINAL): YELLOW OWNER COPY (INITIAL): PINK