IREDELL COUNTY HEALTH DEPARTMENT

STATESVILLE 704-878-5305 MOORESVILLE 704-664-5281

IMPROVEMENT PERMIT / AUTHORIZATION TO CONSTRUCT / OPERATION PERMIT / EXISTING SYSTEM INSPECTION

PERMIT# 80215 PIN# ~~4649666644 PT~~ 4649667532 DATE 4/15/99

OWNER OR CONTRACTOR PIEDMONT HOUSING PHONE: Business Home

ADDRESS 1040 CHARLOTTE HWY TROUTMAN

LOCATION 115 N. TL FLOWERHOUSE TL RANKIN HILL - TRIANGLE - ON LT

SUBDIVISION WESTWINDS BLOCK / SECTION 2 LOT 45 LOT AREA .51 AC SITE CLASS. PS DESIGN FLOW 360 L.T.A.R. .30 PD/PP

Septic Tank: 1000 Gallons; STB 1012 Date 3/9/99

Pump Tank: Gallons; PT Date

Pump Make: Model Serial No.

Nitrification Field: No Fields 1 Square Feet 900 Linear Feet 300

No Lines 5 @ 60' Trench Width 36" Max Trench Bottom Depth 36" Gravel Depth N/A

☑ New System ☐ Repair System Type: I, II, (III), IV, V, VI

System Description: GRAVITY 25% REDUCTION

Repair System Description: PUMP PLANTED

Maintenance Agreement Required: ☐ Yes ☑ No

☑ House/Mod. Home No. Bedrooms 3

☐ Mobile Home No. Bathrooms 2

☐ Business No. Employees

☐ Other


☐ Slab ☑ Crawl Space ☐ Basement w/plumbing ☐ Basement wo/plumbing

Water Supply: ☑ Individual ☐ Public ☐ Community

Comments:/Conditions:

Comments:/Conditions:

INITIAL SITE SKETCH 1"=60'

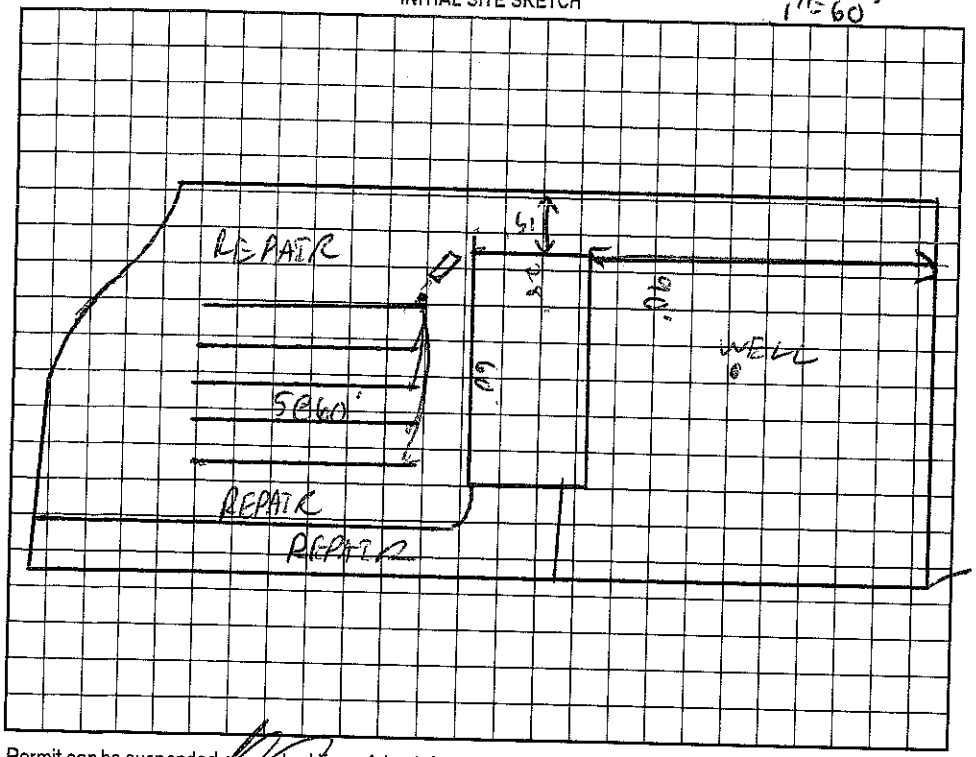

AS BUILT SKETCH

Permit can be suspended or revoked if any false information is supplied toward securing the permit/any unauthorized changes are made to the site/any unauthorized changes are made in the installation of the system. Improvement Permit with plat valid without expiration. Improvement Permit with site plan valid for sixty months. Authorization to Construct is valid for a period equal to that of Improvement Permit – not to exceed sixty months.

Signed: date 4-26-99

Improvement Permit by: C. Yates ES date 4/15/99

Authorization to Construct by: C. Yates ES date 4/15/99

Installed by: A1 BACKHOE

Operation Permit by: D.M. Mozley date 5/6/99

Existing System Inspection by: date

HEALTH DEPT. COPY: WHITE OWNER COPY (FINAL): YELLOW OWNER COPY (INITIAL): PINK