"As Built" for Easement Area

IREDELL COUNTY HEALTH DEPARTMENT

STATESVILLE 704-878-5305 MOORESVILLE 704-664-5281

IMPROVEMENT PERMIT / AUTHORIZATION TO CONSTRUCT / OPERATION PERMIT / EXISTING SYSTEM INSPECTION

PERMIT# 080833 PIN# 4649667891 PT DATE 4/19/2001

OWNER OR CONTRACTOR Fleetwood / Sonya Blackwell PHONE: Business Home

ADDRESS 125 Hazel Ln

LOCATION

SUBDIVISION Westwinds BLOCK / SECTION 2 LOT 49/46A LOT AREA SITE CLASS. DESIGN FLOW L.T.A.R.

Septic Tank: 1000 Gallons; STB 794 Date 10-17-00
Pump Tank: 1000 Gallons; PT 283 Date 11-12-00
Pump Make: Model Serial No.
Nitrification Field: No Fields 1 Square Feet 1200 Linear Feet 300
No Lines 4 Trench Width 36" Max Trench Bottom Depth 36" Gravel Depth N/A

☒ New System ☐ Repair System Type: I, II, III, IV, V, VI
System Description: Pump-"EZ-Flow"
Repair System Description: Pump- Panel Block
Maintenance Agreement Required: ☐ Yes ☒ No

☒ House/Mod. Home No. Bedrooms 3
☐ Mobile Home No. Bathrooms 2
☐ Business No. Employees
☐ Other


☐ Slab ☒ Crawl Space ☐ Basement w/plumbing ☐ Basement wo/plumbing

Water Supply: ☐ Individual ☐ Public ☐ Community


Comments:/Conditions:

Comments:/Conditions: 4-"EZ Flow" lines installed in Drainfield

Scale 1:40 INITIAL SITE SKETCH

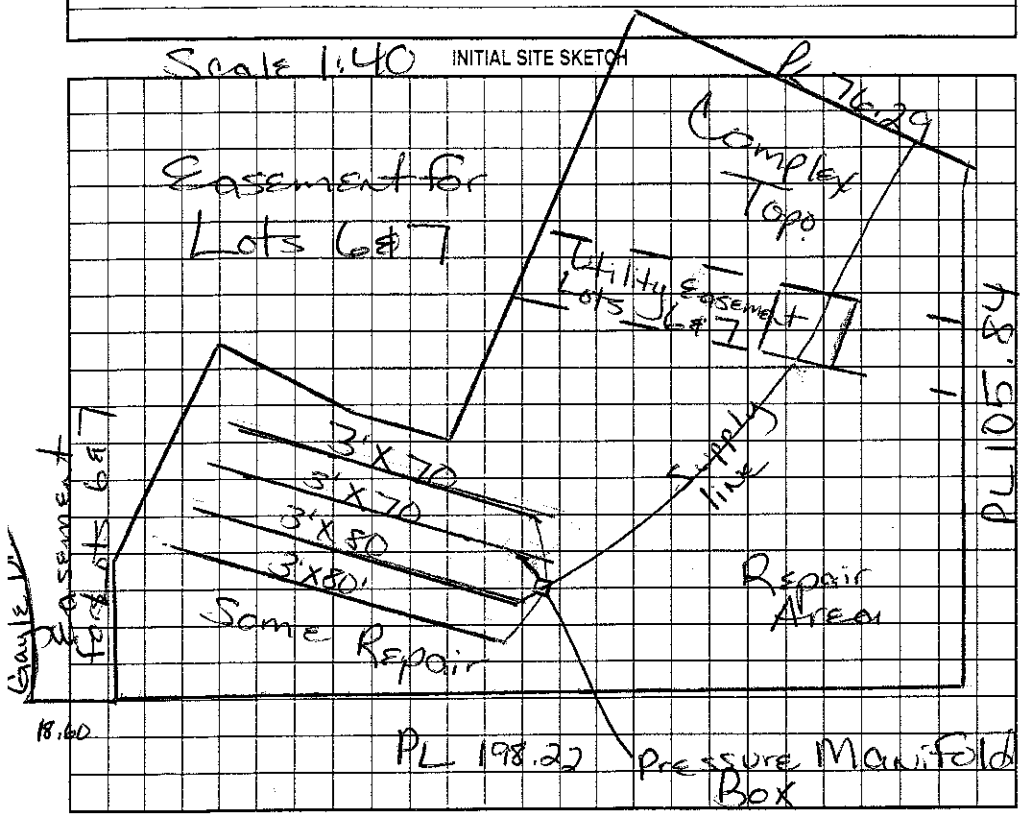

AS BUILT SKETCH

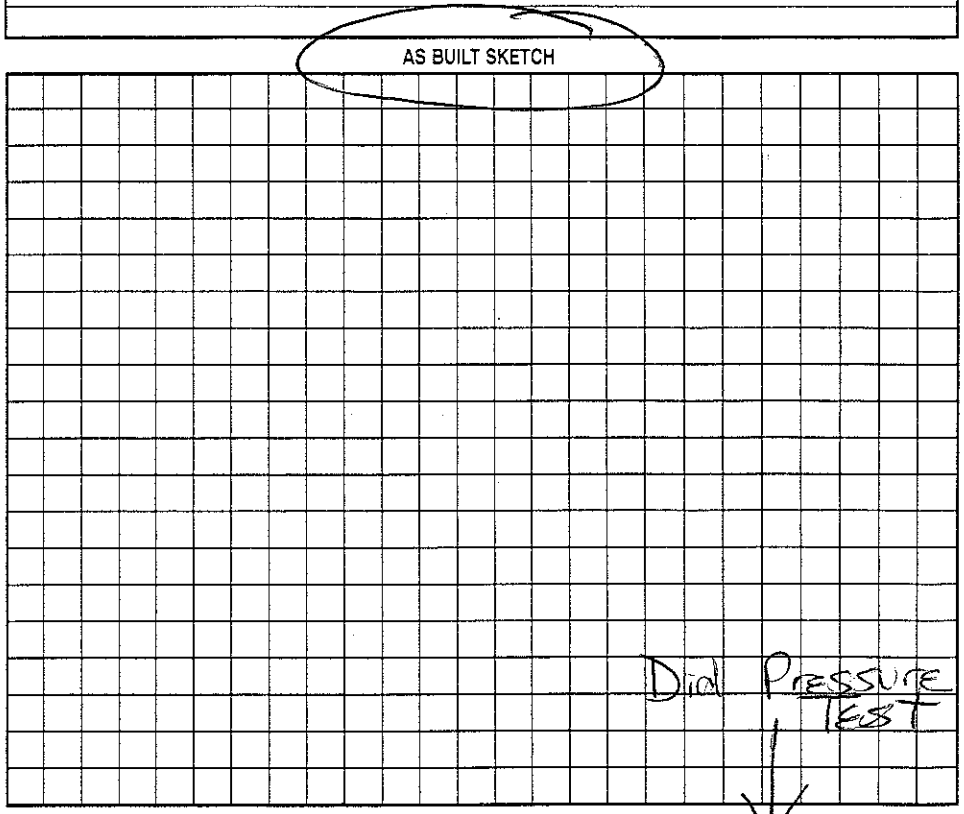

Permit can be suspended or revoked if any false information is supplied toward securing the permit/any unauthorized changes are made to the site/any unauthorized changes are made in the installation of the system. Improvement Permit with plat valid without expiration. Improvement Permit with site plan valid for sixty months. Authorization to Construct is valid for a period equal to that of Improvement Permit – not to exceed sixty months.

Signed: date

Improvement Permit by: date

Authorization to Construct by: date

Installed by: L&L Development / Carolina Pipe Cleaning

Operation Permit by: Maria H.H. Dotson R.S. date 4/19/2001

Existing System Inspection by: date

HEALTH DEPT. COPY: WHITE OWNER COPY (FINAL): YELLOW OWNER COPY (INITIAL): PINK

IREDELL COUNTY HEALTH DEPARTMENT

STATESVILLE 704-878-5305 DT 125.00 Paid 3:30 MOORESVILLE 704-664-5281

IMPROVEMENT PERMIT / AUTHORIZATION TO CONSTRUCT / OPERATION PERMIT / EXISTING SYSTEM INSPECTION

PERMIT# 080833 PIN# ~~4649668891 PT~~ ~~IA~~ 4649668900 DATE 10/27/2000

OWNER OR CONTRACTOR Piedmont Housing/Fleetwood PHONE: Business 528-7120 Home 663-2226 Johnny Craven

ADDRESS 1040 Charlotte Hwy Troutman, NC 28166

LOCATION Flowerhouse Lp. TL Rankin Hill TL Hazelwood

SUBDIVISION Westwinds BLOCK / SECTION 2 LOT 49/46A LOT AREA 1.1 Acre Excluding Easement SITE CLASS. PS DESIGN FLOW 360gpd L.T.A.R. .3

Septic Tank: 1000 Gallons; STB 794 Date 10-17-00
Pump Tank: 1000 Gallons; PT 293 Date 11-17-00
Pump Make: Myers Model ME.50S-11 Serial No. 25325D00
Nitrification Field: No. Fields 1 Square Feet 900' Linear Feet 300'
No Lines 4 at 75' ea (@ 30" 380) Trench Width 36" Max Trench Bottom Depth _____ Gravel Depth N/A


☒ New System ☐ Repair System Type: I, II, III, IV, V, VI
System Description: Pump (PM) 25% Reduction
Repair System Description: Pump - Innovative
Maintenance Agreement Required: ☐ Yes ☒ No
☐ Slab ☒ Crawl Space ☐ Basement w/plumbing ☐ Basement wo/plumbing

☐ House/Mod. Home ☒ Mobile Home ☐ Business ☐ Other
No. Bedrooms 3 No. Bathrooms 2 No. Employees ____

Water Supply: ☒ Individual ☐ Public ☐ Community

Comments:/Conditions: Keep Septic System at least 10' From PL & 5' From MH & 50' From any well.

INITIAL SITE SKETCH Scale 1:60

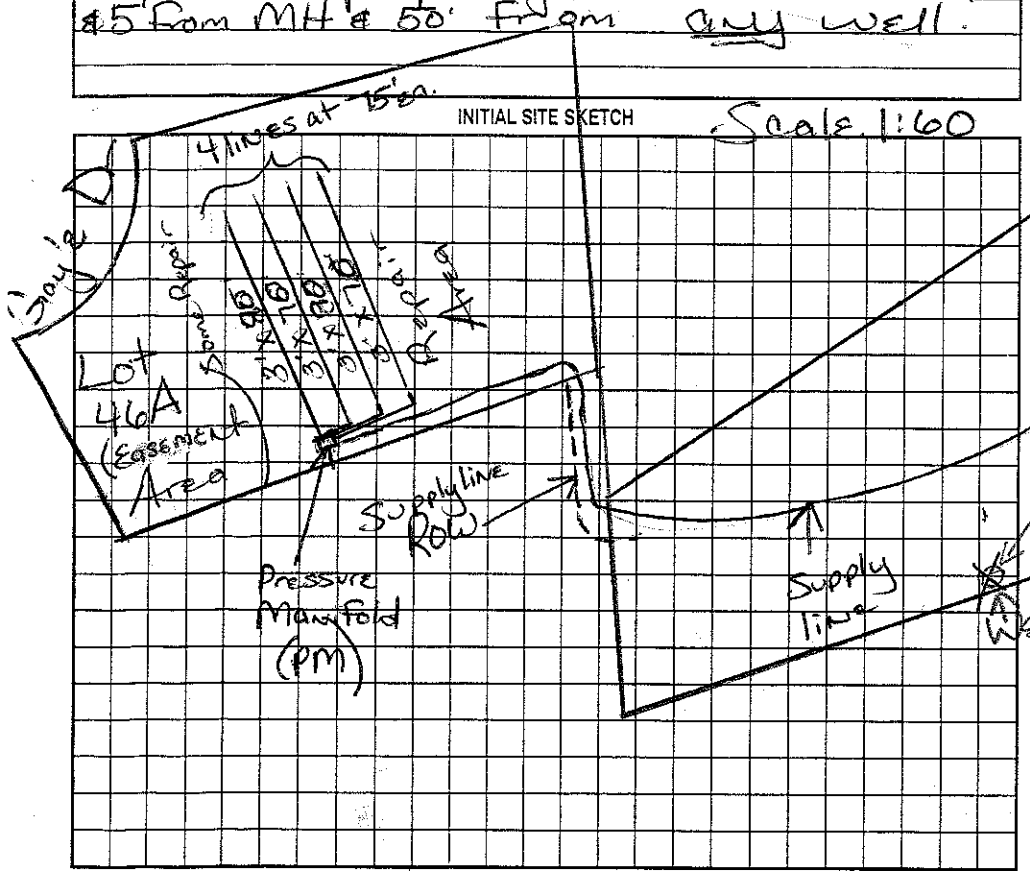

Comments:/Conditions: Checked Drainfield & Tanks ☒ Septic Drainfield located "off-site" on Lot 46A. 10/31/00

AS BUILT SKETCH Checked Electric & Alarm 4/17/01

See As Built Attached

Permit can be suspended or revoked if any false information is supplied toward securing the permit/any unauthorized changes are made to the site/any unauthorized changes are made in the installation of the system. Improvement Permit with plat valid without expiration. Improvement Permit with site plan valid for sixty months. Authorization to Construct is valid for a period equal to that of Improvement Permit – not to exceed sixty months.

Signed: RM Hall date 12/6/2000 Installed by: L&L Developments

Improvement Permit by: Maria H. Dotson RS date 10/30/2000 Operation Permit by: Maria H. Dotson RS date 4/19/2001

Authorization to Construct by: Maria H. Dotson RS date 10/31/2000 Existing System Inspection by: _____ date _____

HEALTH DEPT. COPY: WHITE OWNER COPY (FINAL): YELLOW OWNER COPY (INITIAL): PINK