# IREDELL COUNTY HEALTH DEPARTMENT

STATESVILLE 704-878-5305 / 1250 Paid MOORESVILLE 704-664-5281

## IMPROVEMENT PERMIT / AUTHORIZATION TO CONSTRUCT / OPERATION PERMIT / EXISTING SYSTEM INSPECTION

PERMIT# 100421 PIN# 4649666978 DATE 5/1/2001

OWNER OR CONTRACTOR Westwinds LLC PHONE: Business 663-2220 Home

ADDRESS P.O. Box 1732 Lincolnton, NC 28092

LOCATION Hwy 21/115 TL Flowerhouse TL Rankin Hill approx 1 mile on right

SUBDIVISION Westwinds BLOCK / SECTION I LOT 6 LOT AREA .55 Acre SITE CLASS. PS DESIGN FLOW 360 gpd L.T.A.R. .3

Septic Tank: 1000 Gallons: STB 794 Date 10/12/01

Pump Tank: 1000 Gallons; PT 17 Date 10/3/01

Pump Make: Hydromatic Model 1/2 HP Serial No.

Nitrification Field: No Fields 1 Square Feet 900' Linear Feet 300'

No Lines 3 at 100' Trench Width 36" Max Trench Bottom Depth 36" Gravel Depth N/A

☒ New System ☐ Repair System Type: I, II, III, IV, V, VI

System Description: Pump - 25% Reduction Easement

Repair System Description: Pump - Panel Blk

Maintenance Agreement Required: ☐ Yes ☒ No

☐ House/Mod. Home ☒ Mobile Home ☐ Business ☐ Other

No. Bedrooms 3 No. Bathrooms 3 No. Employees

Water Supply: ☒ Individual ☐ Public ☐ Community

☐ Slab ☒ Crawl Space ☐ Basement w/plumbing ☐ Basement wo/plumbing


Comments:/Conditions: Remove old berms/terraces

* Divert stormwater away/around Drainfield. Must divert drainage from Neighbor's Culvert down PL & away from Drainfield.


Comments:/Conditions: Keep Drainfield at least 10' from PL & 50' from any well. Septic Drainfield located "off-site" in Easement area. Okay to put drive on either side.

Scale 1:40

INITIAL SITE SKETCH

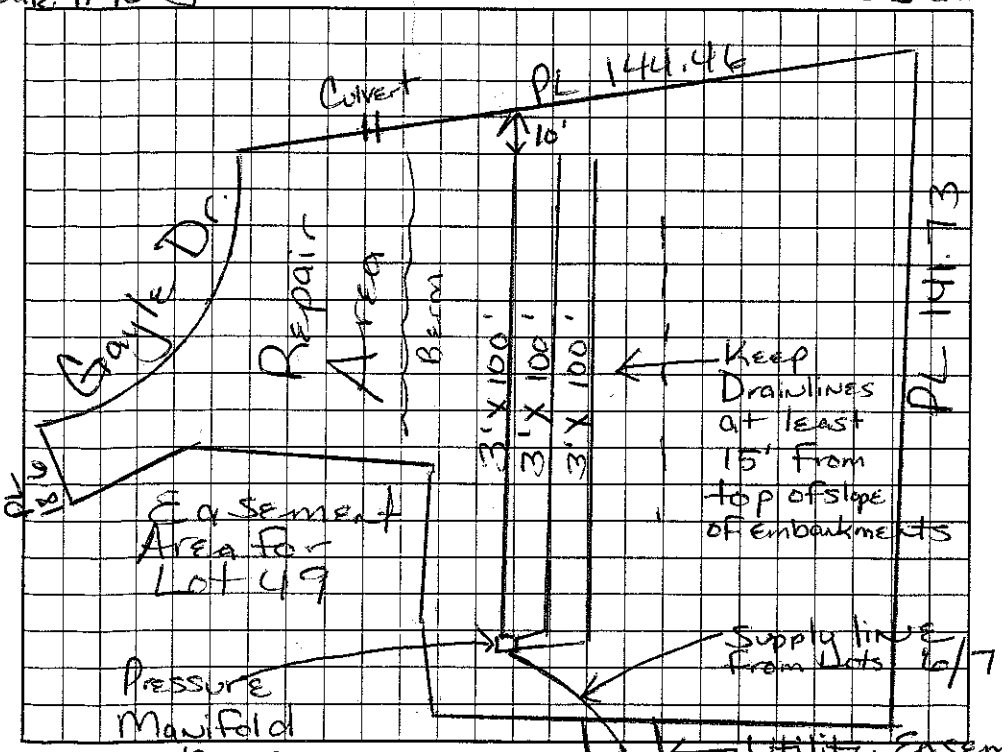


AS BUILT SKETCH

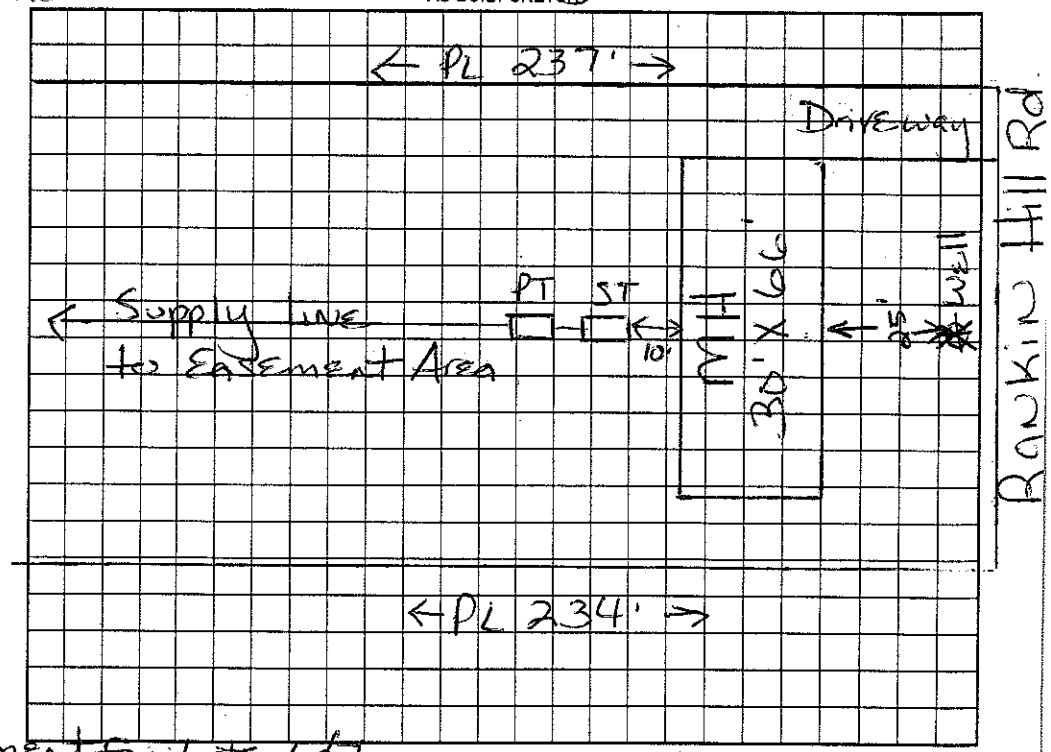


Permit can be suspended or revoked if any false information is supplied toward securing the permit/any unauthorized changes are made to the site/any unauthorized changes are made in the installation of the system. Improvement Permit with plat valid without expiration. Improvement Permit with site plan valid for sixty months. Authorization to Construct is valid for a period equal to that of Improvement Permit – not to exceed sixty months.

Signed: 5-2-01 date 5-2-01 Installed by: Craig Thompson

Improvement Permit by: Maria H. Dotson RS date 5/2/2001 Operation Permit by: date 11/26/01

Authorization to Construct by: Maria H. Dotson RS. date 5/2/2001 Existing System Inspection by: date

HEALTH DEPT. COPY: WHITE OWNER COPY (FINAL): YELLOW OWNER COPY (INITIAL): PINK