Paid 125.00 6-16-00

IREDELL COUNTY HEALTH DEPARTMENT

STATESVILLE 704-878-5305 MOORESVILLE 704-664-5281

IMPROVEMENT PERMIT / AUTHORIZATION TO CONSTRUCT / OPERATION PERMIT / EXISTING SYSTEM INSPECTION

PERMIT# 79578 PIN# 4649669868 DATE 6/14/00

OWNER OR CONTRACTOR PIEDMONT HOUSING PHONE: Business 528-7120 Home

ADDRESS 1040 CHARLOTTE HWY TROUTMAN NC 28166

LOCATION 115N- TL FLOWERHOUSE - TL RANKINHILL 1MILE ON RT

SUBDIVISION WESTWINDS BLOCK / SECTION 1 LOT 8 LOT AREA .51C SITE CLASS. PS DESIGN FLOW 360GPD L.T.A.R. .35gpd/ft²

Septic Tank: 1000 Gallons; STB 1012 Date 4/17/00
Pump Tank: 1000 Gallons; PT 17 Date 5/24/00
Pump Make: BOULDS Model WEO-511H Serial No. 3020330611
Nitrification Field: No Fields 1 Square Feet 900 Linear Feet 300
No Lines 4@75' Trench Width 36" Max Trench Bottom Depth 24-30" Gravel Depth N/A

☑ New System ☐ Repair System Type: I, II, III, IV, V, VI
System Description: PUMP 25% REDUCTION
Repair System Description: PUMP OFFSITE PANEL 9A
Maintenance Agreement Required: ☐ Yes ☑ No


☑ House/Mod. Home No. Bedrooms 3
☑ Mobile Home No. Bathrooms 3
☐ Business No. Employees
☐ Other
☐ Slab ☑ Crawl Space ☐ Basement w/plumbing ☐ Basement wo/plumbing

Water Supply: ☐ Individual ☐ Public ☐ Community


Comments:/Conditions: 30-GPM

Comments:/Conditions:

INITIAL SITE SKETCH 1"= 50'

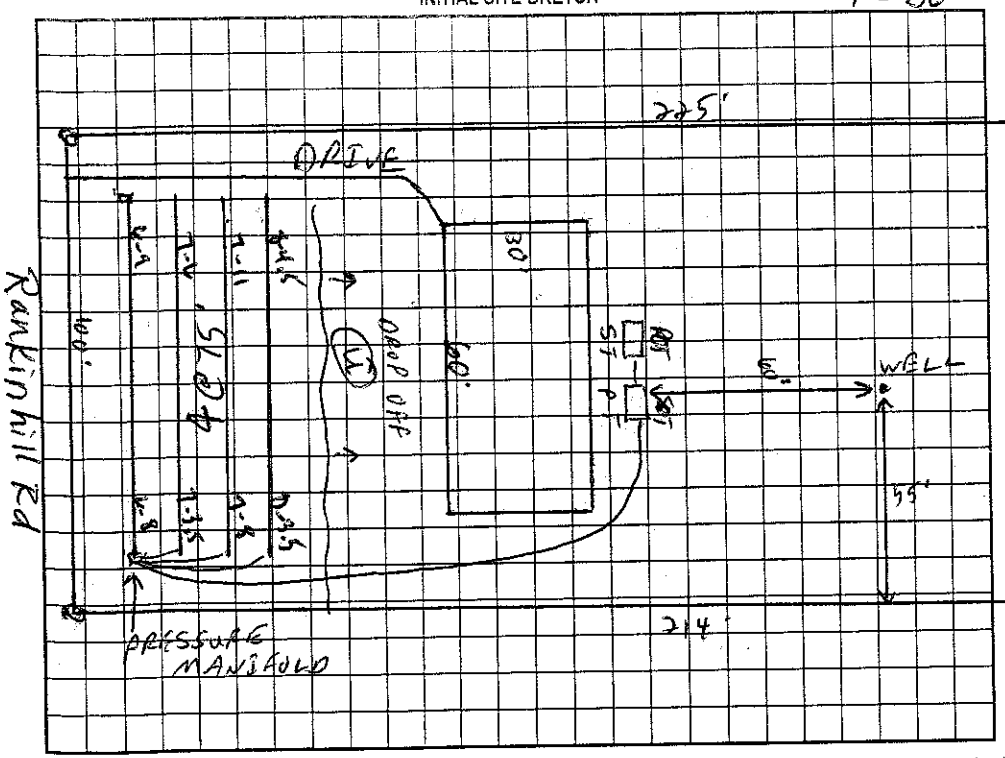

AS BUILT SKETCH

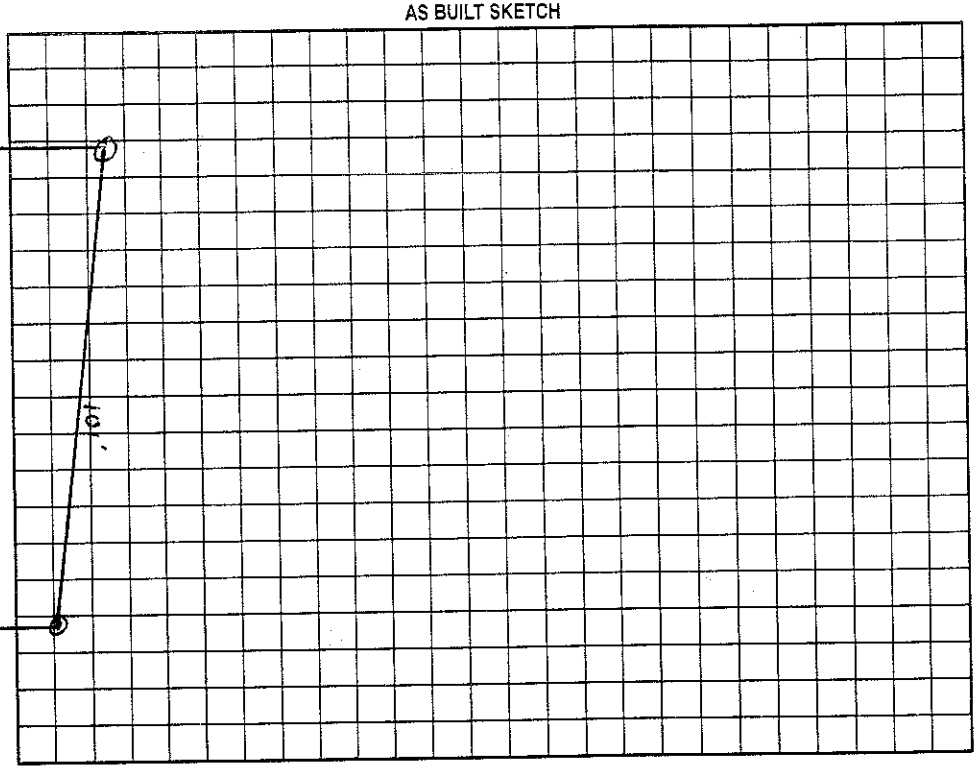

Permit can be suspended or revoked if any false information is supplied toward securing the permit/any unauthorized changes are made to the site/any unauthorized changes are made in the installation of the system. Improvement Permit with plat valid without expiration. Improvement Permit with site plan valid for sixty months. Authorization to Construct is valid for a period equal to that of Improvement Permit – not to exceed sixty months.

Signed: _____ date 6-15-00 Installed by: Craig Thompson

Improvement Permit by: _____ RS date 6/14/00 Operation Permit by: _____ RS date 8/8/2000

Authorization to Construct by: _____ RS date 6/14/00 Existing System Inspection by: _____ date _____

HEALTH DEPT. COPY: WHITE OWNER COPY (FINAL): YELLOW OWNER COPY (INITIAL): PINK