4:00

IREDELL COUNTY HEALTH DEPARTMENT

STATESVILLE 704-878-5305 MOORESVILLE 704-664-5281

IMPROVEMENT PERMIT / AUTHORIZATION TO CONSTRUCT / OPERATION PERMIT / EXISTING SYSTEM INSPECTION

PERMIT# 80835 PIN# ~~4649667891.PT~~ 4649676255 DATE 3/31/01

OWNER OR CONTRACTOR FLEETWOOD HOMES PHONE: Business 528-7120 Home

ADDRESS 1040 CHARLOTTE HWY - TROUTMAN NC 28166

LOCATION 2IN - TL FIRST FLOWER HOUSE - TL RANKEN HILL - SEPTIC FIELD ON RT

SUBDIVISION WESTWINDS BLOCK / SECTION 2 LOT 53354 LOT AREA — SITE CLASS. PS DESIGN FLOW @ 360GPD L.T.A.R. - 360/LOT 2

Septic Tank: 1000 Gallons; STB Date

Pump Tank: 1000 Gallons; PT Date

Pump Make: Model Serial No.

Nitrification Field: No Fields 1 Square Feet 900 Linear Feet 300

No Lines 4@75' Trench Width 36" Max Trench Bottom Depth 36" Gravel Depth N/A

☑ New System ☐ Repair System Type: I, II, III, IV, V, VI offsite

System Description: PUMP 25% REDUCTION

Repair System Description: LPP

Maintenance Agreement Required: ☐ Yes ☑ No

☑ House/Mod. Home No. Bedrooms 3

☐ Mobile Home No. Bathrooms 3

☐ Business No. Employees

☐ Other


☐ Slab ☑ Crawl Space ☐ Basement w/plumbing ☐ Basement wo/plumbing

Water Supply: ☑ Individual ☐ Public ☐ Community


Comments:/Conditions: (REVISED)

Comments:/Conditions:

INITIAL SITE SKETCH 1"=100'

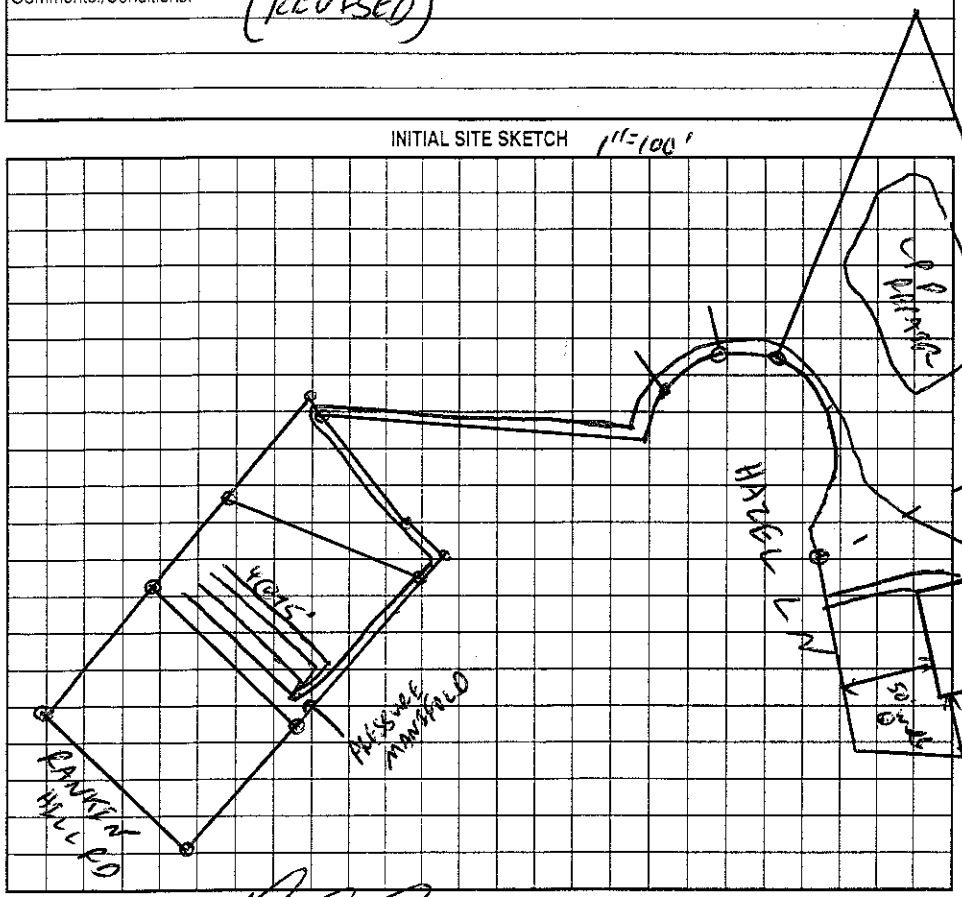

AS BUILT SKETCH

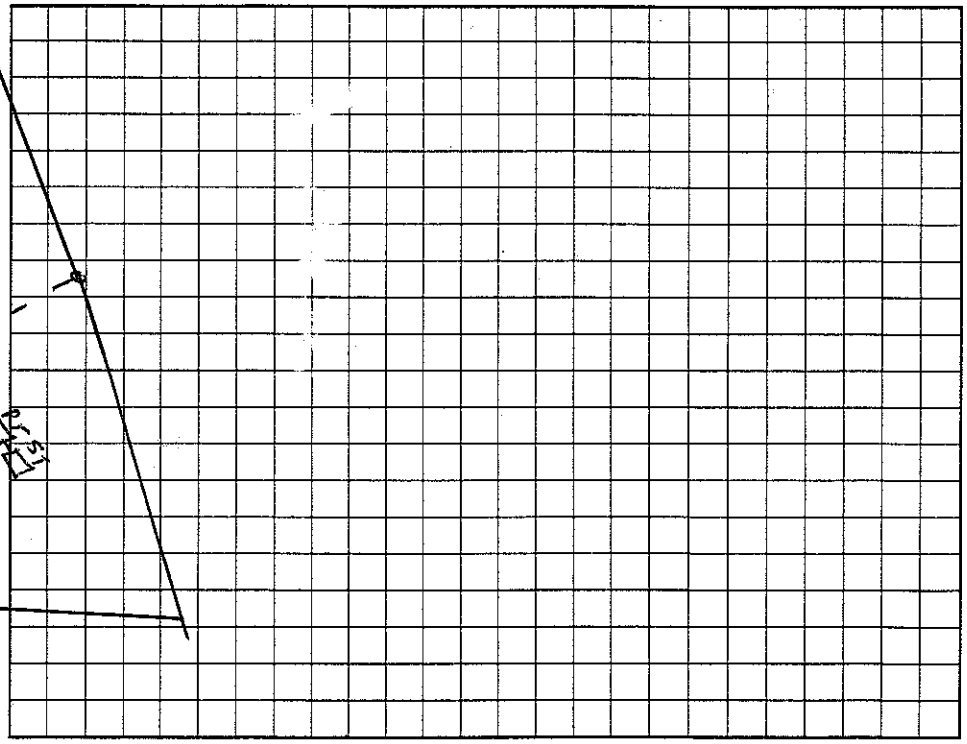

Permit can be suspended or revoked if any false information is supplied toward securing the permit/any unauthorized changes are made to the site/any unauthorized changes are made in the installation of the system. Improvement Permit with plat valid without expiration. Improvement Permit with site plan valid for sixty months. Authorization to Construct is valid for a period equal to that of Improvement Permit – not to exceed sixty months.

Signed: date

Improvement Permit by: C. [illegible] S date 5/31/01

Authorization to Construct by: C. [illegible] S date 5/31/01

Installed by: Craig Thompson

Operation Permit by: [illegible] RSI date 8/13/01

Existing System Inspection by: date

HEALTH DEPT. COPY: WHITE OWNER COPY (FINAL): YELLOW OWNER COPY (INITIAL): PINK