(4:00)

IREDELL COUNTY HEALTH DEPARTMENT

STATESVILLE 704-878-5305 MOORESVILLE 704-664-5281

IMPROVEMENT PERMIT / AUTHORIZATION TO CONSTRUCT / OPERATION PERMIT / EXISTING SYSTEM INSPECT

PERMIT# 079412 PIN# 4649667891 PT 4649 67 7357 DATE 3/12/99

OWNER OR CONTRACTOR PIEDMONT HOUSE NO PHONE: Business Home

ADDRESS 1040 CHARLOTTE HWY STATESMAN NC 28166

LOCATION 115 S - TL FLOWERHOUSE LP. TL RANKEN HELL TR HAZEL - D.N RT

SUBDIVISION WESTWINDS BLOCK / SECTION 2 LOT 52 LOT AREA 1.68 SITE CLASS. PS DESIGN FLOW 450 L.T.A.R. .30-90

Septic Tank: 1000 Gallons; STB 1012 Date 1-4-99

Pump Tank: Gallons; PT Date

Pump Make: Model Serial No.

Nitrification Field: No Fields 1 Square Feet 1200 Linear Feet 400

No Lines 5 @ 80' Trench Width 36" Max Trench Bottom Depth 36" Gravel Depth N/A

☑ New System ☐ Repair System Type: I, II, (III), IV, V, VI

System Description: GRAVITY CHAMBERS ORITE

Repair System Description: PANEL

Maintenance Agreement Required: ☐ Yes ☑ No

☑ House/Mod. Home No. Bedrooms 4

☐ Mobile Home No. Bathrooms 4

☐ Business No. Employees

☐ Other


☐ Slab ☑ Crawl Space ☐ Basement w/plumbing ☐ Basement wo/plumbing

Water Supply: ☑ Individual ☐ Public ☐ Community

Comments:/Conditions:

Comments:/Conditions:

INITIAL SITE SKETCH 1" = 50'

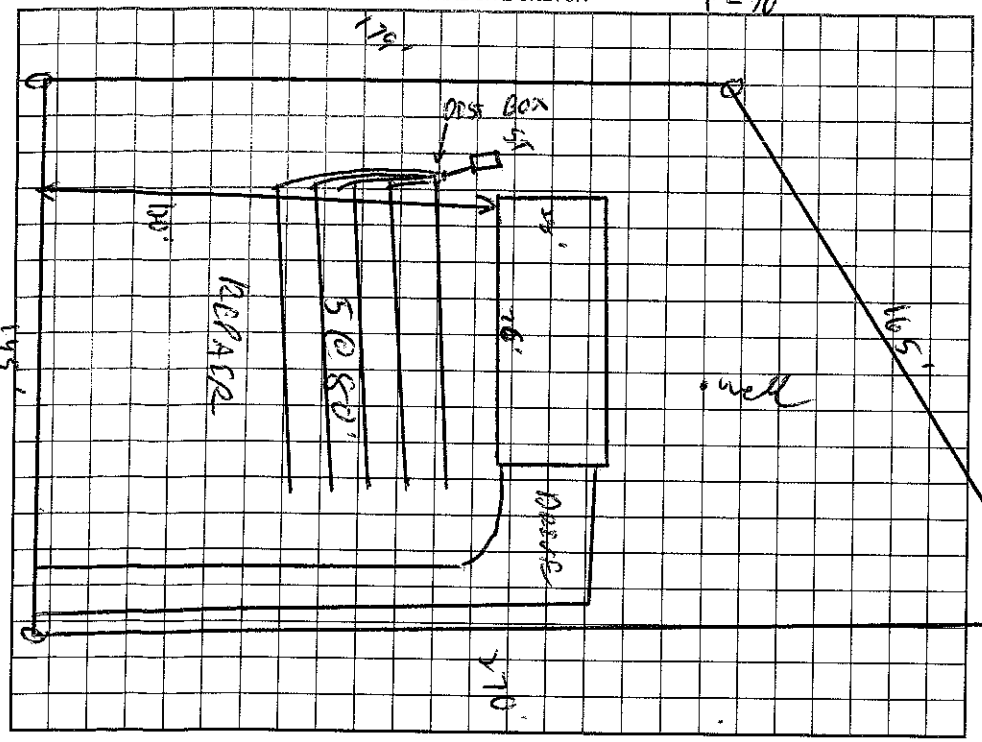

AS BUILT SKETCH

Permit can be suspended or revoked if any false information is supplied toward securing the permit/any unauthorized changes are made to the site/any unauthorized changes are made in the installation of the system. Improvement Permit with plat valid without expiration. Improvement Permit with site plan valid for sixty months. Authorization to Construct is valid for a period equal to that of Improvement Permit – not to exceed sixty months.

Signed: CR date 3-12-99 Installed by: A-1 Backhoe

Improvement Permit by: C. Ryan Thomas RS date 3/12/99 Operation Permit by: Jeff Morgan date 3/16/99

Authorization to Construct by: C. Ryan Thomas RS date 3/12/99 Existing System Inspection by: date

HEALTH DEPT. COPY: WHITE OWNER COPY (FINAL): YELLOW OWNER COPY (INITIAL): PINK