IREDELL COUNTY HEALTH DEPARTMENT

STATESVILLE 704-878-5305 MOORESVILLE 704-664-5281

IMPROVEMENT PERMIT / AUTHORIZATION TO CONSTRUCT / OPERATION PERMIT / EXISTING SYSTEM INSPECTION

125.00 Paid 4:00

PERMIT# 80834 PIN# ~~4649 667 891 PF~~ 4649678008 DATE 2/24/01

OWNER OR CONTRACTOR Piedmont Housing PHONE: Business 528-7120 Home

ADDRESS 1040 Charlotte Hwy, Troutman NC 28166

LOCATION Roaring Hill, TR Hazel, on Lt.

SUBDIVISION West Winds BLOCK / SECTION 2 LOT 50 LOT AREA .50 AC SITE CLASS. PS DESIGN FLOW 360 L.T.A.R. 0.3

Septic Tank: 1000 Gallons; STB 312 Date 9-14-99

Pump Tank: 1000 Gallons; PT 283 Date 1-26-01

Pump Make: Model Serial No.

Nitrification Field: No Fields 1 Square Feet 600 Linear Feet 200

No Lines 4@50 Trench Width 24"-36" Max Trench Bottom Depth 36" Gravel Depth —

☒ New System ☐ Repair System Type: I, II, III, IV, V, VI

System Description: PM - Panel Block

Repair System Description: LP Panel Block

Maintenance Agreement Required: ☐ Yes ☒ No

☐ House/Mod. Home ☒ Mobile Home ☐ Business ☐ Other


No. Bedrooms 3 No. Bathrooms 2 No. Employees

Water Supply: ☒ Individual ☐ Public ☐ Community

☐ Slab ☒ Crawl Space ☐ Basement w/plumbing ☐ Basement wo/plumbing


Comments/Conditions: * Existing well must be abandoned according to NC Abandonment Rules - Keep New well 50' minimum from Septic System + Repair

INITIAL SITE SKETCH

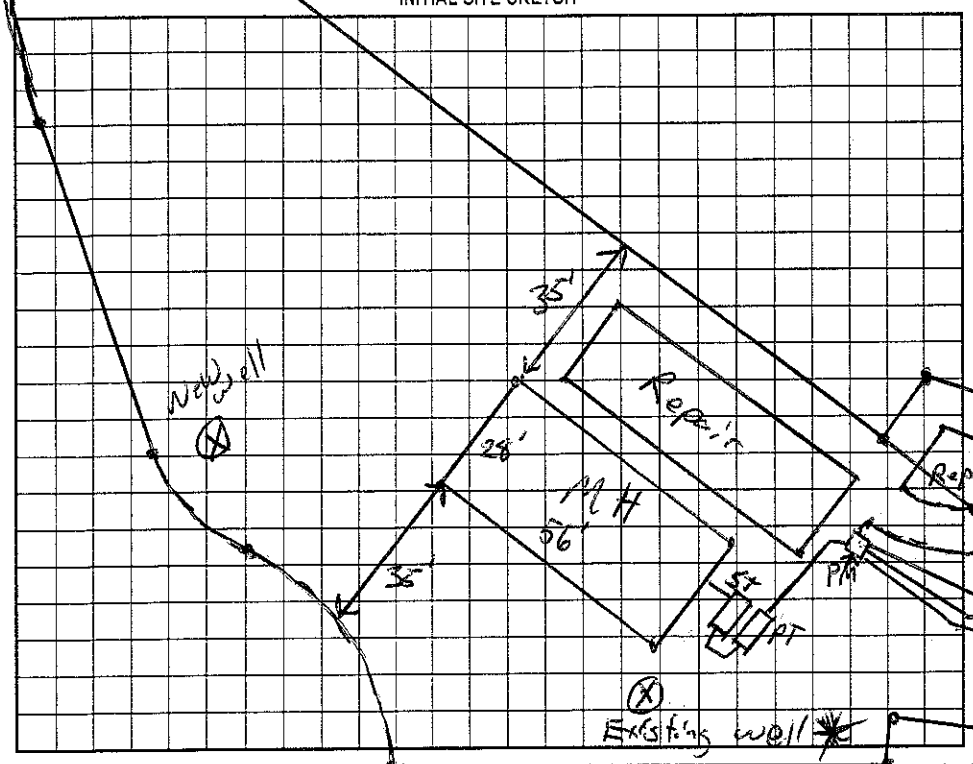

Comments/Conditions: Filter not installed yet 3/9/2001 mp
Checked tanks 3/9/2001 mp
1st line inspected 3/9/2001 mp
Pressure, Elect. & Alarm checked 4/10/01

AS BUILT SKETCH

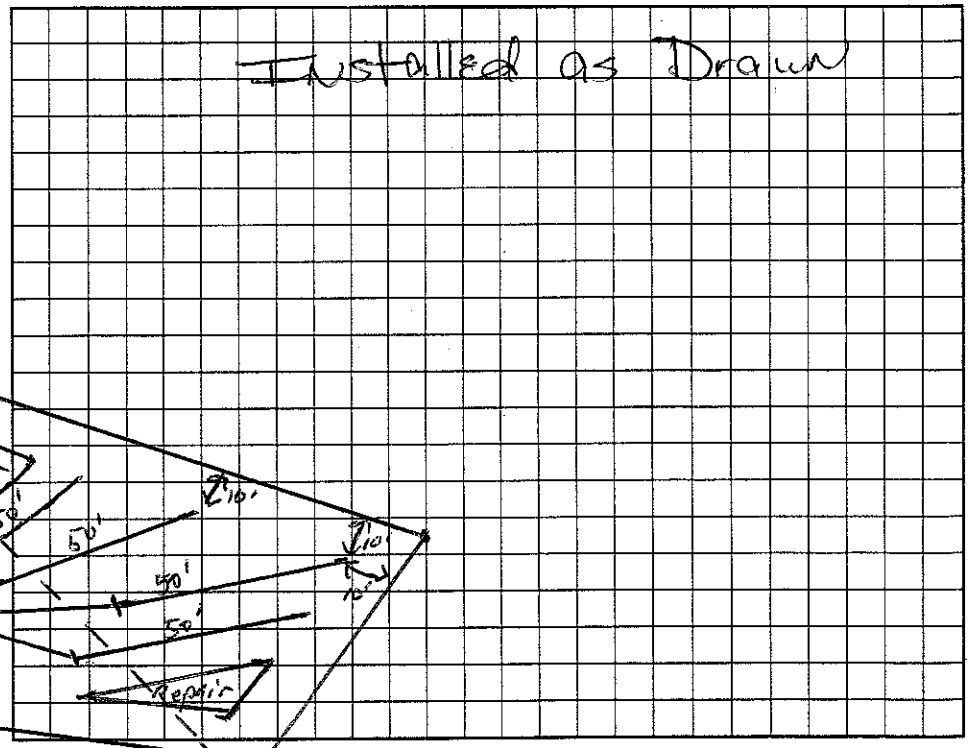

Permit can be suspended or revoked if any false information is supplied toward securing the permit, any unauthorized changes are made to the site, any unauthorized changes are made in the installation of the system. Improvement Permit with plat valid without expiration. Improvement Permit with site plan valid for sixty months. Authorization to Construct is valid for a period equal to that of Improvement Permit – not to exceed sixty months.

Signed: Darrell N. Reed date 3-1-01

Improvement Permit by: RSI date 2/24/01

Authorization to Construct by: RSI date 2/24/01

Installed by: Craig Thompson

Operation Permit by: Marsha H. Stone B.S. date 4/10/01

Existing System Inspection by: date

HEALTH DEPT. COPY: WHITE OWNER COPY (FINAL): YELLOW OWNER COPY (INITIAL): PINK