4:00

IREDELL COUNTY HEALTH DEPARTMENT

STATESVILLE 704-878-5305 MOORESVILLE 704-664-5281

IMPROVEMENT PERMIT / AUTHORIZATION TO CONSTRUCT / OPERATION PERMIT / EXISTING SYSTEM INSPEC

PERMIT# 078792 PIN# 4649667591 PT 4649678548 DATE 1/28/99

OWNER OR CONTRACTOR THOMAS CHRISTOPHER PHONE: Business _____ Home 525-7120

ADDRESS 1040 CHARLOTTE HWY

LOCATION 115 S TL FLOWERHOUSE - TL RANKIN HILL - TR HAZEL DR ET

SUBDIVISION WESWINDS BLOCK / SECTION 2 LOT 51 LOT AREA 1.13 AC SITE CLASS. PS DESIGN FLOW 480 L.T.A.R. .36 GPD/FT

Septic Tank: 1000 Gallons; STB ~~1000~~ 1000 Date 11/30/98

Pump Tank: _____ Gallons; PT _____ Date _____

Pump Make: _____ Model _____ Serial No. _____

Nitrification Field: No Fields 1 Square Feet 1200 Linear Feet 400

No Lines 4@100' Trench Width 36" Max Trench Bottom Depth 36" Gravel Depth N/A

☑ New System ☐ Repair System Type: I, II, III, IV, V, VI

System Description: GRAVITY CHAMBERS

Repair System Description: PANEL

Maintenance Agreement Required: ☐ Yes ☑ No

☑ House/Mod. Home No. Bedrooms 4

☐ Mobile Home No. Bathrooms 1

☐ Business No. Employees _____

☐ Other _____

☐ Slab ☑ Crawl Space ☐ Basement w/plumbing ☐ Basement wo/plumbing


Water Supply: ☑ Individual ☐ Public ☐ Community

Comments:/Conditions:

Comments:/Conditions:

TANK ON OTHER SIDE OF HOUSE

INITIAL SITE SKETCH NOT TO SCALE

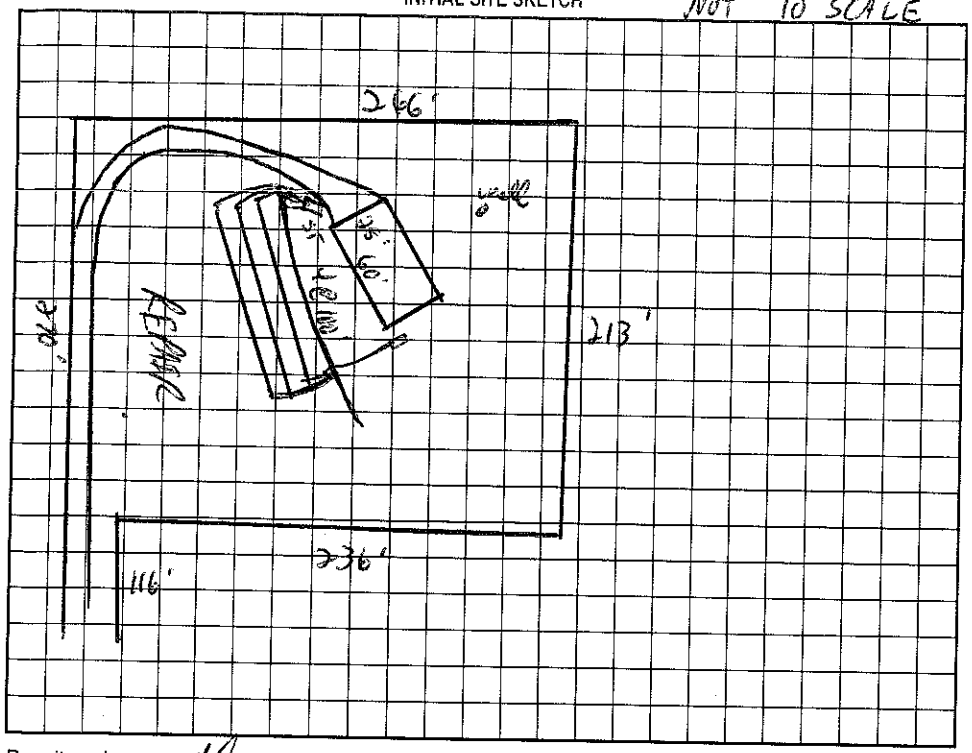

AS BUILT SKETCH

Permit can be suspended or revoked if any false information is supplied toward securing the permit/any unauthorized changes are made to the site/any unauthorized changes are made in the installation of the system. Improvement Permit with plat valid without expiration. Improvement Permit with site plan valid for sixty months. Authorization to Construct is valid for a period equal to that of Improvement Permit – not to exceed sixty months.

Signed: _____ date 2-4-99 Installed by: A1 BACKHOE

Improvement Permit by: _____ date 1/28/99 Operation Permit by: _____ date 2/5/99

Authorization to Construct by: _____ date 1/28/99 Existing System Inspection by: _____ date _____

HEALTH DEPT. COPY: WHITE OWNER COPY (FINAL): YELLOW OWNER COPY (INITIAL): PINK