IREDELL COUNTY HEALTH DEPARTMENT

STATESVILLE 704-878-5305 MOORESVILLE 704-664-5281

IMPROVEMENT PERMIT / AUTHORIZATION TO CONSTRUCT / OPERATION PERMIT / EXISTING SYSTEM INSPECTION

PERMIT# 074112 PIN# ~~4649-66-7897~~ 4649679452 DATE 6/17/98

OWNER OR CONTRACTOR Wm. L. Heafner PHONE: Business 528-7120 Home

ADDRESS PO Box 1732 Lincolnton NC 28093

LOCATION Rankin Hill Rd. on (R) before Thoroughbred Lane

SUBDIVISION Westwind BLOCK / SECTION 1 LOT 12 LOT AREA 1.92 SITE CLASS. PS DESIGN FLOW 480 L.T.A.R. .3

Septic Tank: 1000 Gallons; STB 1012 Date 4-16-98

Pump Tank: Gallons; PT Date

Pump Make: Model Serial No.

Nitrification Field: No Fields 1 Square Feet 1200 Linear Feet 400

No Lines 4 Trench Width 36" Max Trench Bottom Depth 30" Gravel Depth STND.

☒ New System ☐ Repair System Type: I, II, (III) IV, V, VI

System Description: GRAV-CH PLASTIC *

Repair System Description: 16" PPBS

Maintenance Agreement Required: ☐ Yes ☒ No

☒ House/Mod. Home ☐ Mobile Home ☐ Business ☐ Other

No. Bedrooms 4 No. Bathrooms 2 No. Employees

☐ Slab ☒ Crawl Space ☐ Basement w/plumbing ☐ Basement wo/plumbing


Water Supply: ☒ Individual ☐ Public ☐ Community

Comments:/Conditions:


Comments:/Conditions:

HOUSE NOT SAT OR WELL NOT LOCATED 6/19/98

INITIAL SITE SKETCH

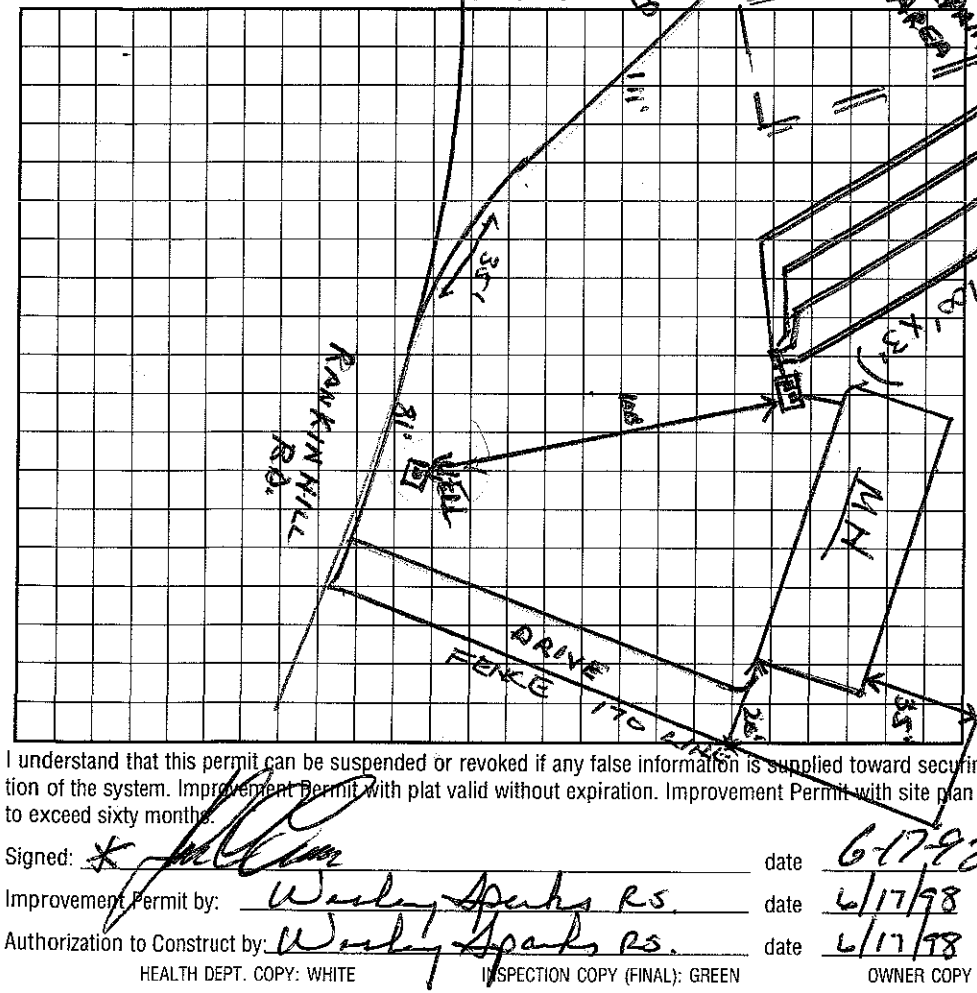

AS BUILT SKETCH

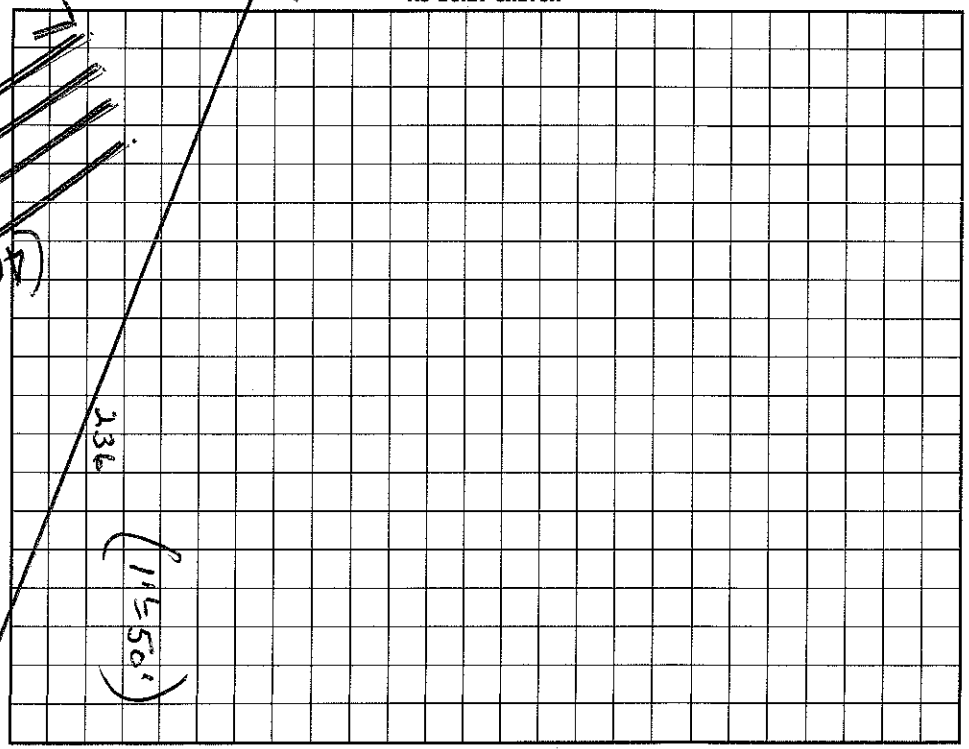

I understand that this permit can be suspended or revoked if any false information is supplied toward securing the permit/any unauthorized changes are made to the site/any unauthorized changes are made in the installation of the system. Improvement Permit with plat valid without expiration. Improvement Permit with site plan valid for sixty months. Authorization to Construct is valid for a period equal to that of Improvement Permit – not to exceed sixty months.

Signed: * date 6-17-98 Installed by: A1 BACKHOE

Improvement Permit by: Wesley Sparks RS. date 6/17/98 Operation Permit by: C. date 6/19/98

Authorization to Construct by: Wesley Sparks RS. date 6/17/98 Existing System Inspection by: date

HEALTH DEPT. COPY: WHITE INSPECTION COPY (FINAL): GREEN OWNER COPY (FINAL): YELLOW INSPECTION COPY (INITIAL): PINK OWNER COPY (INITIAL): GOLD