IREDELL COUNTY HEALTH DEPARTMENT

STATESVILLE 704-878-5305 MOORESVILLE 704-664-5281

PIN# 4649-69-0985

IMPROVEMENT PERMIT / CERTIFICATE OF COMPLETION / OPERATION PERMIT / EXISTING SYSTEM INSPECTION

PROPERTY DESCRIPTION NO. 17382 DATE 11/3/93 TAX MAP NO. 4F 3A 11 Watershed: ☑ Yes ☐ No

OWNER OR CONTRACTOR MARLO CORP [SARAH BOWERS] ~~PHONE: Business~~ Home 664-6735

ADDRESS CARLYLE RD, TL 2ND MARLO LA. LOT ON R IN CURVE

LOCATION

SUBDIVISION CARLYLE FARMS BLOCK / SECTION 1 LOT 11 LOT AREA ~.75 AC SITE CLASS. DESIGN FLOW L.T.A.R.

Septic Tank: Gallons; STB Date

Pump Tank: Gallons; PT Date

Pump Make: Model Serial No.

Nitrification Field: No Fields 1 Square Feet 710 Linear Feet 240

No Lines 3 Trench Width 3' Max Trench Bottom Depth 3' Gravel Depth 12"

☐ New System ☐ Repair System Type: I (II) III, IV, V, VI

System Description: EXISTING SYSTEM

Repair System Description:

Maintenance Agreement Required: ☐ Yes ☐ No

☐ House/Mod. Home ☑ Mobile Home ☐ Business ☐ Other

No. Bedrooms 3 No. Bathrooms 2 No. Employees

☐ Slab ☑ Crawl Space ☐ Basement w/plumbing ☐ Basement wo/plumbing


Water Supply: ☐ Individual ☑ Community ☐ Public

Comments:

Comments:

INITIAL SITE SKETCH

AS BUILT SKETCH

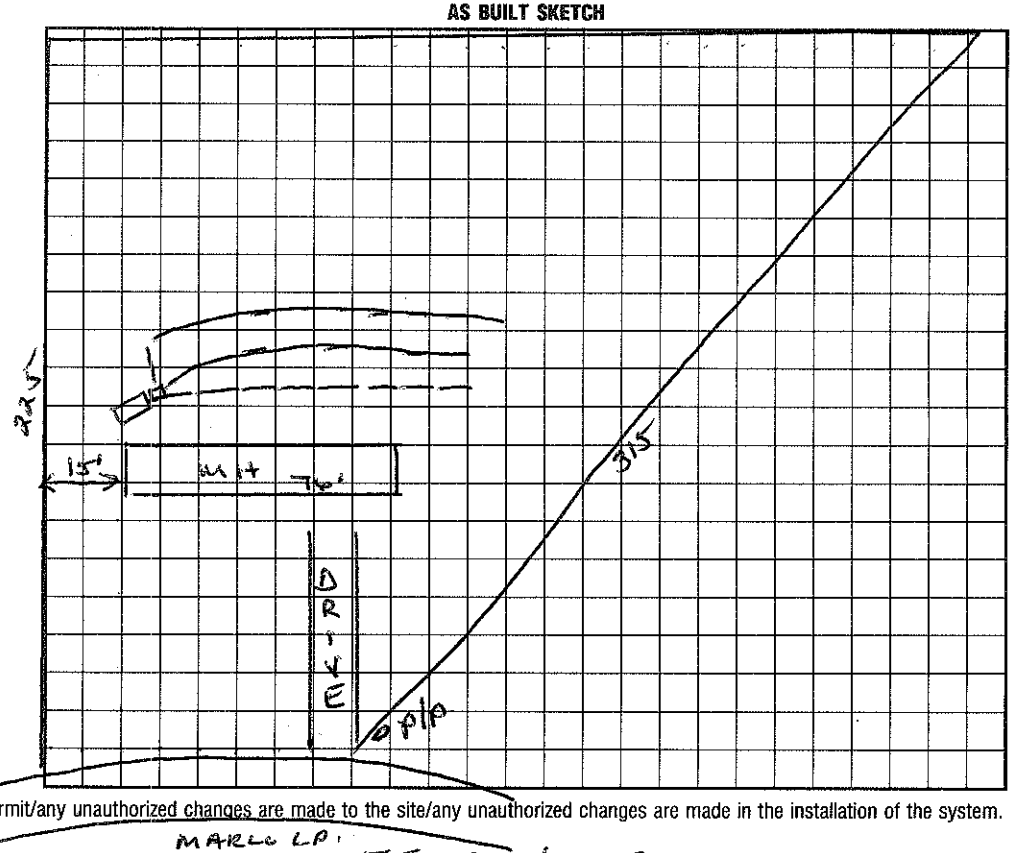

I understand that this permit can be suspended or revoked if any false information is supplied toward securing the permit/any unauthorized changes are made to the site/any unauthorized changes are made in the installation of the system. Improvement Permit is valid for 60 months from date of issuance.

Signed:

Installed by: FJ ERVIN 5-7-86

Improvement Permit by: date

Existing System Inspection by: Wesley Sparks RS. date 11/3/93

Certificate of Completion by: date

Operation Permit by: date

HEALTH DEPT. COPY: WHITE INSPECTION COPY (FINAL): GREEN OWNER COPY (FINAL): YELLOW INSPECTION COPY (INITIAL): PINK OWNER COPY (INITIAL): GOLD